

MARION
J 2056
12-27-79

MISSISSIPPI
 BOARD OF WATER COMMISSIONERS
 416 North State Street
 Jackson, Mississippi 39201

WATER WELL DRILLERS LOG

12-27 1979 Hollins MARION
 date well completed firm name county well located

LANDOWNER: V. Kay Morgan
RT1
Kokomo, MS
 (mailing address)

description of formations encountered	from	to
<u>CHALK CLAY</u>	<u>0</u>	<u>50</u>
<u>sand, gravel</u>	<u>50</u>	<u>87</u>

WELL LOCATION:
 sec. 30 T. 3(N) S. R. 12(E) W.
2 1/2 miles W of Kokomo
 (distance) (direction) (nearest town)

WELL PURPOSE: Home
 (home, irrigation, municipal, industrial)

WELL COMPLETION DATA:

(1) diameter (inches) 2

(2) total depth (feet) 87

(3) static water level (feet) 55 below above top of ground.

(4) casing pvc 82
 (material) (depth)
 (size) If telescope see back.

(5) screen 5 82
 (length) (depth to top)
2 pvc
 (size) (material)

(6) pump 1/2 6
 (HP) (yield gpm)
elect
 (type power)

(7) electric log
 (yes or no)

 (organization running log)

(8) how well bottom plugged SAND
5' @ 12'

DRILLERS REMARKS: Good
well


DEPT. OF NATURAL RESOURCES
 BUREAU OF LAND & WATER RESOURCES

JAN 15 1980

RECEIVED

If well telescopes please sketch and show depths.

GROUND LEVEL

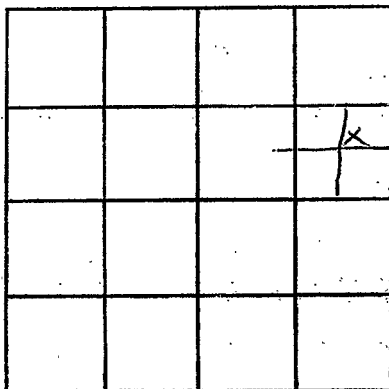

SECTION 30

Please indicate well location X.

ADDITIONAL INFORMATION

If more than one screen, show locations of each on sketch.