

MARION

J 2057
4-10-80

MISSISSIPPI
BOARD OF WATER COMMISSIONERS
416 North State Street
Jackson, Mississippi 39201

WATER WELL DRILLERS LOG

4-10 1980 Hollinsie Marion
date well completed firm name county well located

LANDOWNER: J.C. McGowan
RT 1
Foxworth, MS
(mailing address)

Description of formations encountered	from	to
sand, gravel, rock	0	120
clay	120	150
pea gravel	150	200

WELL LOCATION:
sec 36 T 36 N R 18 E 12E
S W
5 miles W of Foxworth
(distance) (direction) (nearest town)

WELL PURPOSE: Farm
(home, irrigation, municipal, industrial)

- WELL COMPLETION DATA:
- (1) diameter (inches) 2"
 - (2) total depth (feet) 200
 - (3) static water level (feet) 120 below top of ground.
 - (4) casing pvc (material), (depth), (size) If telescope see back.
 - (5) screen 10 90 (length) (depth to top)
2 pvc (size) (material)
 - (6) pump 1 1/2 9 (HP) (yield gpm)
elect (type power)
 - (7) electric log (yes or no)

(organization running log)
(8) how well bottom plugged sand SHARK

DRILLERS REMARKS: good well


DEPT. OF NATURAL RESOURCES
BUREAU OF LAND & WATER RESOURCES

JUL 21 1980

RECEIVED

If well telescopes please sketch and show depths.

GROUND LEVEL

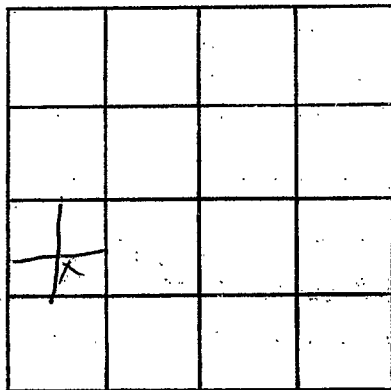

SECTION 36

Please indicate well location X.

ADDITIONAL INFORMATION

If more than one screen, show locations of each on sketch.