

MARION  
J 2058  
4-24-80

MISSISSIPPI  
 BOARD OF WATER COMMISSIONERS  
 416 North State Street  
 Jackson, Mississippi 39201

WATER WELL DRILLERS LOG

4-24 1980 F. J. Special Well Serv Marion  
 date well completed firm name county well located

LANDOWNER:	description of formations encountered	from	to
<u>Richard Cucumono</u>			
<u>RR, Kokomo</u> (mailing address)	<u>Red clay</u>	<u>0</u>	<u>20</u>
<b>WELL LOCATION:</b>	<u>Red sand</u>	<u>20</u>	<u>150</u>
sec <u>27</u> T <u>3N</u> S R <u>12E</u> W	<u>Green sand &amp; gravel</u>	<u>150</u>	<u>166</u>
<u>1</u> miles <u>E</u> of <u>Kokomo</u> (distance) (direction) (nearest town)			
<b>WELL PURPOSE:</b> (home, irrigation, municipal, industrial)			
<b>WELL COMPLETION DATA:</b>			
(1) diameter (inches) <u>4</u>			
(2) total depth (feet) <u>166</u>			
(3) static water level (feet) <u>80</u> below above top of ground.			
(4) casing <u>PVC</u> , <u>158</u> , (material) (depth)			
<u>4</u> if telescope see back. (size)			
(5) screen <u>8</u> , <u>158</u> (length) (depth to top)			
<u>4</u> , <u>PVC</u> (size) (material)			
(6) pump <u>1/2</u> <u>10</u> (HP) (yield gpm)			
<u>elec</u> (type power)			
(7) electric log <u>no</u> (yes or no)			
(organization running log)			
(8) how well bottom plugged <u>sealed</u>			

DEPT. OF NATURAL RESOURCES  
 BUREAU OF LAND & WATER RESOURCES


JUN 20 1980

RECEIVED

DRILLERS REMARKS:

If well telescopes please sketch and show depths.

GROUND LEVEL

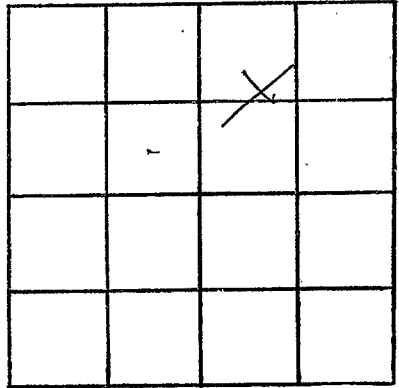

SECTION 27

Please indicate well location X.

ADDITIONAL INFORMATION

If more than one screen, show locations of each on sketch.