

MARION

J 2059

4-19-80

4-19

MISSISSIPPI
BOARD OF WATER COMMISSIONERS
416 North State Street
Jackson, Mississippi 39201

WATER WELL DRILLERS LOG

date well completed

1980 Hollinsworth

firm name

MARION

county well located

LANDOWNER: Jimmy Crump

RT 1 Box 258

Foxworth, Ms.
(mailing address)

description of formations encountered

from to

Red clay, gravel	0	60
sand, gravel	60	100
pea gravel	100	107

WELL LOCATION:

sec. 6 T 30 N R 19 E
S W
6 miles W of Foxworth
(distance) (direction) (nearest town)

WELL PURPOSE:
(home, irrigation, municipal, industrial)

WELL COMPLETION DATA:

- (1) diameter (inches) 2
- (2) total depth (feet) 107
- (3) static water level (feet) 50 below top of ground.
- (4) casing PVC, 102 (material) (depth)
- (size) if telescope see back.
- (5) screen 5, 102 (length) (depth to top)
- 2, PVC (size) (material)
- (6) pump 1, 8 (HP) (yield gpm)
- elect (type power)
- (7) electric log (yes or no)

(organization running log)

(8) how well bottom plugged Sand SHARK

DRILLERS REMARKS: Good well


DEPT. OF NATURAL RESOURCES
BUREAU OF LAND & WATER RESOURCES

JUL 21 1980

RECEIVED

If well telescopes please sketch and show depths.

GROUND LEVEL

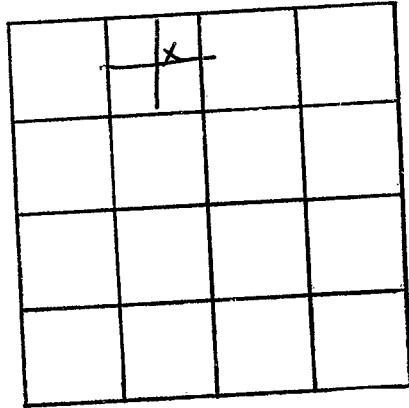

SECTION 6

Please indicate well location X.

ADDITIONAL INFORMATION

If more than one screen, show locations of each on sketch.