

MARION

J 2060

5-5-80

5-5

MISSISSIPPI BOARD OF WATER COMMISSIONERS  
416 North State Street  
Jackson, Mississippi 39201

WATER WELL DRILLERS LOG

1980 Hollinger  
date well completed firm name

MARION  
county well located

LANDOWNER: Archie Thornhill

Rt 1 Box 248  
Forworth, Ms.  
(mailing address)

description of formations encountered

from to

Red clay 0 25  
sandy gravel 25 50  
pea gravel 50 67

WELL LOCATION:

sec. 35 T. 3 (N) S R. 20 (E) W

10 miles W of FORWORTH  
(distance) (direction) (nearest town)

WELL PURPOSE: Home  
(home, irrigation, municipal, industrial)

WELL COMPLETION DATA:

- (1) diameter (inches) 2"
- (2) total depth (feet) 67
- (3) static water level (feet) 6" below top of ground.
- (4) casing PVC, 63  
(material) (depth)  
(size) if telescope see back.
- (5) screen 5, 62  
(length) (depth to top)  
(size) (material)
- (6) pump 1/2, 12  
(HP) (yield gpm)  
elect  
(type power)
- (7) electric log yes or no

(organization running log)

(8) how well bottom plugged SAND  
SPARK

DRILLERS REMARKS: very good well


DEPT. OF NATURAL RESOURCES  
BUREAU OF LAND & WATER RESOURCES

JUL 21 1980

RECEIVED

If well telescopes please sketch and show depths.

GROUND LEVEL

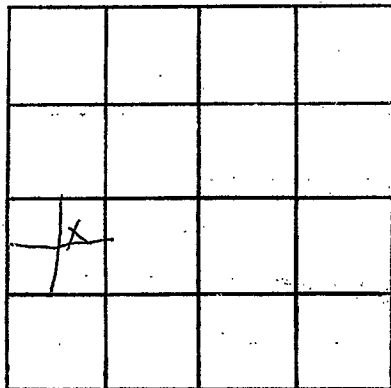

SECTION 35

Please indicate well location X.

ADDITIONAL INFORMATION

If more than one screen,  
show locations of each on sketch.