

Marion
 J 2061
 8/21/80

MISSISSIPPI
 BOARD OF WATER COMMISSIONERS
 416 North State Street
 Jackson, Mississippi 39201

WATER WELL DRILLERS LOG

8-21 1980 *Fluorwell Inc* Marion
 date well completed firm name county well located

LANDOWNER:
 R.E. Ross
 R.R. - Kerkomo
 (mailing address)

description of formations encountered	from	to
Red clay	0	20
Red sand	20	110
Coarse sand & gravel	110	120

WELL LOCATION:
 sec. 29 T. 3 N. R. 12 E.
 S W
 1 miles W of Kerkomo
 (distance) (direction) (nearest town)

WELL PURPOSE: *Home*
 (home, irrigation, municipal, industrial)

- WELL COMPLETION DATA:
- (1) diameter (inches) 4
 - (2) total depth (feet) 120
 - (3) static water level (feet) 75 below above top of ground.
 - (4) casing PVC 112
 (material) (depth)
4 if telescope see back.
 (size)
 - (5) screen 8 112
 (length) (depth to top)
4 PVC
 (size) (material)
 - (6) pump 1/2 10
 (HP) (yield gpm)
Gas
 (type power)
 - (7) electric log no
 (yes or no)
 (organization running log)
 - (8) how well bottom plugged Sand block

DRILLERS REMARKS:


DEPT. OF NATURAL RESOURCES
 BUREAU OF LAND & WATER RESOURCES

SEP 8 - 1980

RECEIVED

If well telescopes please sketch and show depths.

GROUND LEVEL

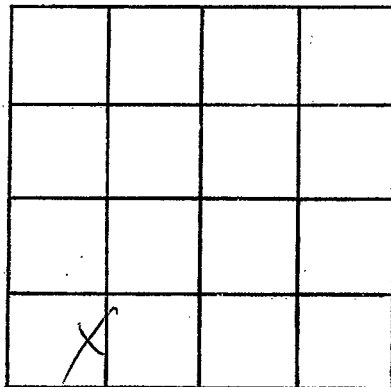

SECTION 29

Please indicate well location X.

ADDITIONAL INFORMATION

A series of 18 horizontal lines for writing additional information.

If more than one screen, show locations of each on sketch.