

MARION
J 2062
8-19-80

MISSISSIPPI
BOARD OF WATER COMMISSIONERS
416 North State Street
Jackson, Mississippi 39201

WATER WELL DRILLERS LOG

8-19 1980 D Hollinger MARION
date well completed fish name county well located

LANDOWNER: Ed Martin
RT 3
Foxworth, Ms.
(mailing address)

description of formations encountered	depth	
	from	to
Sand, gravel	0	100
CHH OK	100	160
pea gravel	160	205

WELL LOCATION:
sec. 9 T 30 N R 12 E
S W
5 miles W of Foxworth
(distance) (direction) (nearest town)

WELL PURPOSE: Home
(home, irrigation, municipal, industrial)

- WELL COMPLETION DATA:
- (1) diameter (inches) 2
 - (2) total depth (feet) 205
 - (3) static water level (feet) 100 below
top of ground.
 - (4) casing pvc, 195,
(material) (depth)
(size) if telescope see back.
 - (5) screen 10, 195
(length) (depth to top)
2, pvc
(size) (material)
 - (6) pump 2, 12
(HP) (yield gpm)
elect
(type power)
 - (7) electric log _____
(yes or no)

(organization running log)

(8) how well bottom plugged sand
SHARK

DRILLERS REMARKS: Good well


DEPT. OF NATURAL RESOURCES
BUREAU OF LAND & WATER RESOURCES

OCT 20 1980

RECEIVED

If well telescopes please sketch and show depths.

GROUND LEVEL

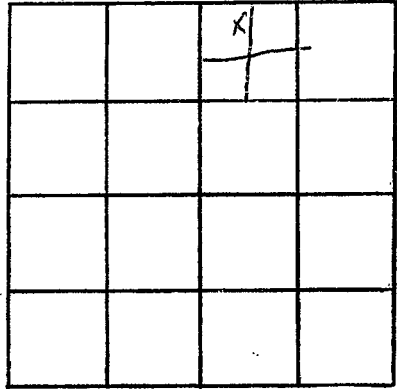

SECTION 9

Please indicate well location X.

ADDITIONAL INFORMATION

If more than one screen, show locations of each on sketch.