

MISSISSIPPI DEPARTMENT OF NATURAL RESOURCES

Bureau of Land and Water Resources

Southport Mall

P.O. Box 10631

Jackson, Mississippi 39209

WATER WELL DRILLERS LOG

Marion
J 2063
3-15-80

March 15 1980 Recess Well Sec Marion
 date well completed firm name county well located

LANDOWNER:
James Prine
P.O. box 308 Fairmont
 (mailing address)
 sec 35 T 3 N R 12 E
3 miles ESE of Kokomo
 (distance) (direction) (nearest town)

description of formations encountered	from	to
<u>Clay</u>	<u>2</u>	<u>17</u>
<u>Red sandy clay</u>	<u>17</u>	<u>95</u>
<u>shells</u>	<u>95</u>	<u>160</u>
<u>Sand & gravel</u>	<u>160</u>	<u>181</u>
<u>white chalk</u>	<u>181</u>	<u>195</u>
<u>Coarse sand</u>	<u>195</u>	<u>210</u>

WELL PURPOSE: home
 (home, irrigation, municipal, industrial)

WELL COMPLETION DATA:
 (1) diameter (inches) 4"
 (2) total depth (feet) 210
 (3) static water level (feet) 172 below top of ground.
 (4) casing plastic bottom
 (material) (depth)
 (size) if telescope see back.
 (5) screen 5' 205'
 (length) (depth to top)
4" plastic
 (size) (material)
 (6) pump 3/4 10
 (HP) (yield gpm)
split
 (type power)
 (7) electric log no
 (yes or no)
 (organization running log)

(8) how well bottom plugged:
wooden plug

DRILLERS REMARKS:
not paid
Faber Bankrupt


DEPT. OF NATURAL RESOURCES
 BUREAU OF LAND & WATER RESOURCES

DEC - 1 1980

RECEIVED

If well telescopes please sketch and show depths.

GROUND LEVEL

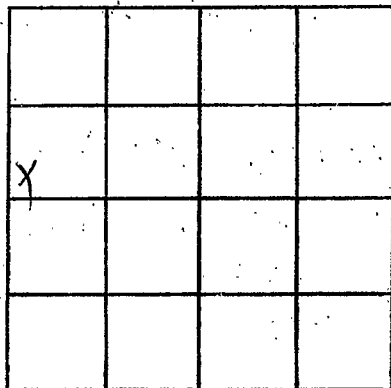

SECTION 38

Please indicate well location X.

ADDITIONAL INFORMATION

If more than one screen,
show locations of each on sketch.