

MARION
J 2064
11-24-80

MISSISSIPPI
BOARD OF WATER COMMISSIONERS
416 North State Street
Jackson, Mississippi 39201

WATER WELL DRILLERS LOG

11-24 1980 *General Well Serv* *marion*
date well completed firm name county well located

LANDOWNER:	description of formations encountered	from	to
<i>Glenn Mace</i>	<i>Red clay</i>	<i>0</i>	<i>20</i>
<i>RR 1, Kekomo</i> (mailing address)	<i>Red sand</i>	<i>20</i>	<i>140</i>
	<i>Coarse sand & gravel</i>	<i>140</i>	<i>152</i>
WELL LOCATION: sec. <i>22</i> T. <i>3</i> N. R. <i>12</i> E <i>2</i> miles <i>NE</i> of <i>Kekomo</i> (distance) (direction) (nearest town)			
WELL PURPOSE: <i>Home</i> (home, irrigation, municipal, industrial)			
WELL COMPLETION DATA:			
(1) diameter (inches) <i>4</i>			
(2) total depth (feet) <i>152</i>			
(3) static water level (feet) <i>90</i> below above top of ground.			
(4) casing <i>206</i> , <i>144</i> , (material) (depth) <i>4</i> if telescope see back. (size)			
(5) screen <i>8</i> , <i>144</i> (length) (depth to top) <i>4</i> , <i>ASC</i> (size) (material)			
(6) pump <i>1/2</i> , <i>10</i> (HP) (yield gpm) <i>Elc</i> (type power)			
(7) electric log <i>N</i> (yes or no) (organization running log)			
(8) how well bottom plugged <i>Good</i>			

DRILLERS REMARKS:


DEPT. OF NATURAL RESOURCES
BUREAU OF LAND & WATER RESOURCES

DEC - 9 1980

RECEIVED

If well telescopes please sketch and show depths.

GROUND LEVEL

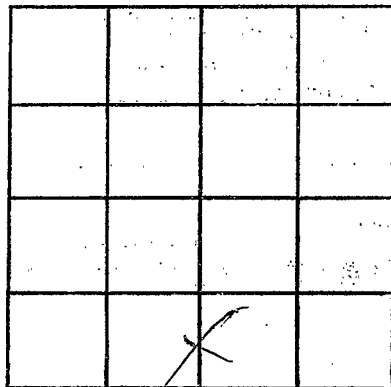

SECTION 22

Please indicate well location X.

ADDITIONAL INFORMATION

If more than one screen, show locations of each on sketch.