

MARION  
J 2065  
12-17-80

MISSISSIPPI  
 BOARD OF WATER COMMISSIONERS  
 416 North State Street  
 Jackson, Mississippi 39201

WATER WELL DRILLERS LOG

12-17 1980  
 date well completed

Fitzgerald Well Serv  
 firm name

Marion  
 county well located

LANDOWNER:

Wendell Cox

R.R. Kokomo

(mailing address)

WELL LOCATION:

sec. 8 T. 3 N R. 12 E  
 S W

6 miles N of Kokomo  
 (distance) (direction) (nearest town)

WELL PURPOSE:

Home  
 (home, irrigation, municipal, industrial)

WELL COMPLETION DATA:

- (1) diameter (inches) 4  
 (2) total depth (feet) 141  
 (3) static water level (feet) 80 below  
 top of ground.

- (4) casing PVC, 133,  
 (material) (depth)

4  
 (size) If telescope see back.

- (5) screen 8, 133  
 (length) (depth to top)

4, PVC  
 (size) (material)

- (6) pump 1/2 10  
 (HP) (yield gpm)

elu  
 (type power)

- (7) electric log no  
 (yes or no)

(organization running log)

- (8) how well bottom plugged Sand filter

description of formations  
 encountered

from

to

Red clay

0 20

Red sand

20 137

Coarse sand & gravel

132 141

DRILLERS REMARKS:


DEPT. OF NATURAL RESOURCES  
 BUREAU OF LAND & WATER RESOURCES

JAN 29 1981

RECEIVED

If well telescopes please sketch and show depths.

GROUND LEVEL

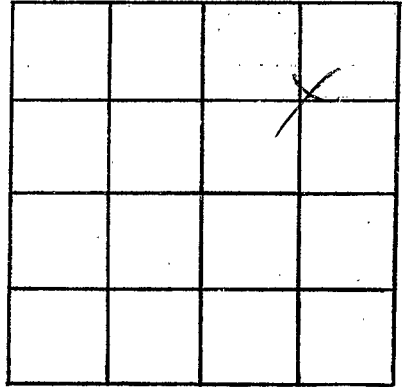

SECTION 8

Please indicate well location X.

ADDITIONAL INFORMATION

If more than one screen, show locations of each on sketch.