

MARION  
J 2066  
1-15-81

MISSISSIPPI  
BOARD OF WATER COMMISSIONERS  
416 North State Street  
Jackson, Mississippi 39201

WATER WELL DRILLERS LOG

date well completed 1-15 19 81 firm name St. Gallenwell Ltd county well located Marion

LANDOWNER:

Bill Jamell Jr.  
R.O. - Kalamo  
(mailing address)

description of formations encountered

from to

<u>Red clay</u>	<u>0</u>	<u>20</u>
<u>Red silt</u>	<u>20</u>	<u>80</u>
<u>Coarse Sandstone</u>	<u>80</u>	<u>97</u>

WELL LOCATION:

sec. 30 T 3 N R 12 E  
S W  
2 miles W of Kalamo  
(distance) (direction) (nearest town)

WELL PURPOSE: Home  
(home, irrigation, municipal, industrial)

WELL COMPLETION DATA:

- (1) diameter (inches) 4
- (2) total depth (feet) 97
- (3) static water level (feet) 45 below above top of ground.
- (4) casing PVC 89  
(material) (depth)
- 4 if telescope see back.  
(size)
- (5) screen 8 89  
(length) (depth to top)
- 4 PVC  
(size) (material)
- (6) pump 1/2 10  
(HP) (yield gpm)
- elec  
(type power)
- (7) electric log no  
(yes or no)

(organization running log)

(8) how well bottom plugged Full plug

DRILLERS REMARKS:


DEPT. OF NATURAL RESOURCES  
BUREAU OF LAND & WATER RESOURCES

JAN 29 1981

RECEIVED

If well telescopes please sketch and show depths.

GROUND LEVEL

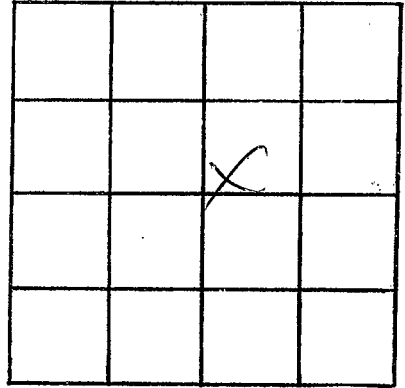

SECTION 30

Please indicate well location X.

ADDITIONAL INFORMATION

If more than one screen,  
show locations of each on sketch.