


MISSISSIPPI DEPARTMENT OF NATURAL RESOURCES
 Bureau of Land and Water Resources
 Southport Mall
 P.O. Box 10631
 Jackson, Mississippi 39209
 WATER WELL DRILLERS LOG

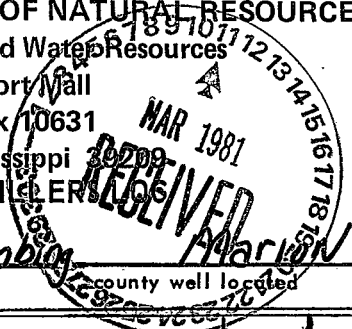

MARTON
J 2067
2/19/81
2/19 1981
 date well completed

81 Dunaways Plumbing
 firm name
Marion
 county well located

LANDOWNER: Jerry Cox
Route 1
Folwell, Mo. 39485
 (mailing address)

description of formations encountered	from to	
	ft	ft
<u>top</u>	<u>0</u>	<u>8</u>
<u>sand & gravel</u>	<u>8</u>	<u>62</u>
<u>Chalk</u>	<u>62</u>	<u>127</u>
<u>sand</u>	<u>127</u>	<u>140</u>

WELL LOCATION:
 sec. 8 T. 3 N. R. 12 E.
3 miles N of Kokomo
 (distance) (direction) (nearest town)

WELL PURPOSE:
 (home) irrigation, municipal, industrial

- WELL COMPLETION DATA:
- (1) diameter (inches) 4 inch
 - (2) total depth (feet) 140 ft.
 - (3) static water level (feet) 80 below above top of ground.
 - (4) casing PVC, 140 ft.
 (material) (depth)
 _____ if telescope see back.
 (size)
 - (5) screen 10 ft., 130 ft.
 (length) (depth to top)
4 inch PVC
 (size) (material)
 - (6) pump 3/4 10
 (HP) (yield gpm)
electric
 (type power)
 - (7) electric log No
 (yes or no)

 (organization running log)
 - (8) how well bottom plugged sand
shack

DEPT. OF NATURAL RESOURCES
 BUREAU OF LAND & WATER RESOURCES


MAR 11 1981

RECEIVED

DRILLERS REMARKS:

If well telescopes please sketch and show depths.

GROUND LEVEL

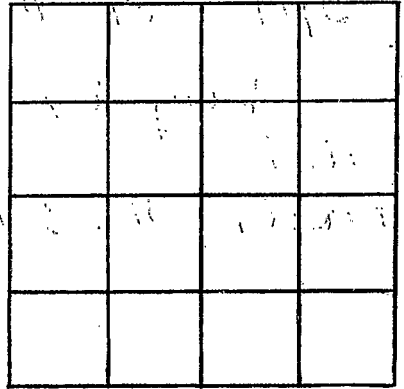

SECTION _____

Please indicate well location X.

ADDITIONAL INFORMATION

If more than one screen,
show locations of each on sketch.