

MISSISSIPPI DEPARTMENT OF NATURAL RESOURCES

Bureau of Land and Water Resources

Southport Mall


P.O. Box 10637

Jackson, Mississippi 39209

WATER WELL DRILLERS LOG

(Cleveland McClary)

Don Away's Plumbing

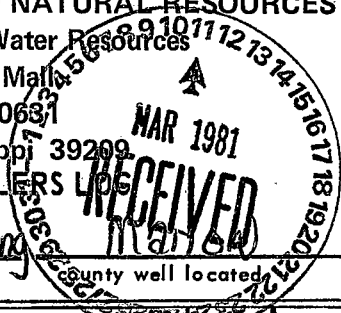

MARION  
J 2068  
2/4/81

2/4 1981  
date well completed

Don Away's Plumbing  
firm name

LANDOWNER: Little Rock Baptist Church  
description of formations encountered

| Route      | from           | to |
|------------|----------------|----|
| <u>0</u>   | <u>4.5 ft.</u> |    |
| <u>4</u>   | <u>54 ft.</u>  |    |
| <u>54</u>  | <u>200 ft.</u> |    |
| <u>200</u> | <u>220 ft.</u> |    |

WELL LOCATION:  
sec. 11 T. 30 N. R. 12 E.  
3 miles W of Sumner  
(distance) (direction) (nearest town)

WELL PURPOSE:  
(Home, irrigation, municipal, industrial)

WELL COMPLETION DATA:

- (1) diameter (inches) 2 inch
- (2) total depth (feet) 220 ft.
- (3) static water level (feet) 100 below above top of ground.
- (4) casing PVC, 220 ft.  
(material) (depth)
- \_\_\_\_\_ if telescope see back.  
(size)
- (5) screen 10, 210  
(length) (depth to top)
- 2 inch, PVC  
(size) (material)
- (6) pump 1/2, 15  
(HP) (yield gpm)
- electric  
(type power)
- (7) electric log NO  
(yes or no)
- \_\_\_\_\_ (organization running log)

(8) how well bottom plugged sand  
sharp

DRILLERS REMARKS:

DEPT. OF NATURAL RESOURCES  
BUREAU OF LAND & WATER RESOURCES

MAR 1 1981

RECEIVED

If well telescopes please sketch and show depths.

GROUND LEVEL

|  |  |  |  |
|--|--|--|--|
|  |  |  |  |
|  |  |  |  |
|  |  |  |  |
|  |  |  |  |

SECTION \_\_\_\_\_

Please indicate well location X.

ADDITIONAL INFORMATION

If more than one screen, show locations of each on sketch.