

MISSISSIPPI DEPARTMENT OF NATURAL RESOURCES

Bureau of Land and Water Resources

Southport Mall

P.O. Box 10631

Jackson, Mississippi 39209

WATER WELL DRILLERS LOG  
(Cleveland McCRAW)

DUNAWAYS Plumbing



MARION  
J 2069  
2/28/81  
228

date well completed

firm name

county well located

LANDOWNER:

J.C. Williamson

Description of formations encountered

from

to

Route 1

Foxworth, Ms. 39483  
(mailing address)

Top  
chalk  
sand

0 6 ft.  
6 80 ft.  
80 90 ft.

WELL LOCATION:

sec 30 T. 30 N. R. 12 E  
3 miles ~~NE~~ SW of Foxworth  
(distance) (direction) (nearest town)

WELL PURPOSE:

Irrigation, municipal, industrial

WELL COMPLETION DATA:

- (1) diameter (inches) 2 inch
- (2) total depth (feet) 90 ft
- (3) static water level (feet) 60 below above top of ground.
- (4) casing PVC 90 ft.  
(material) (depth)

\_\_\_\_\_ if telescope see back.  
(size)

- (5) screen 5 ft. 85 ft.  
(length) (depth to top)
- 2 inch PVC  
(size) (material)

- (6) pump 1/2 9  
(HP) (yield gpm)

Electric  
(type power)

- (7) electric log No  
(yes or no)

\_\_\_\_\_ (organization running log)

- (8) how well bottom plugged sand  
Shank

DRILLERS REMARKS:


DEPT. OF NATURAL RESOURCES  
BUREAU OF LAND & WATER RESOURCES

MAR 11 1981

RECEIVED

If well telescopes please sketch and show depths.

GROUND LEVEL

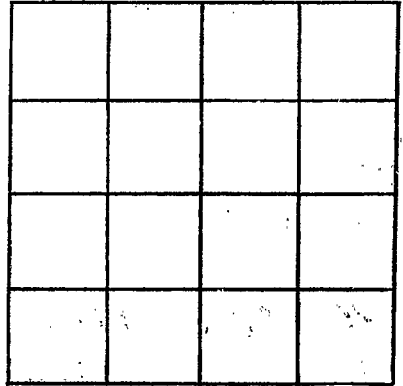

SECTION \_\_\_\_\_

Please indicate well location X.

ADDITIONAL INFORMATION

If more than one screen,  
show locations of each on sketch.