

Marion  
 J 2070  
 5-1-81

MISSISSIPPI  
 BOARD OF WATER COMMISSIONERS  
 416 North State Street  
 Jackson, Mississippi 39201

WATER WELL DRILLERS LOG

5-1 19 81 Hollinger Marion  
 date well completed firm name county well located

LANDOWNER: Jervis Quinn  
RT 3  
Foxworth, MS  
 (mailing address)

description of formations encountered	from	to
<u>sand gravel</u>	<u>0</u>	<u>100</u>
<u>CHALK</u>	<u>100</u>	<u>160</u>
<u>pea gravel</u>	<u>160</u>	<u>200</u>

WELL LOCATION:  
 sec. 9 T. 30 N. R. 12 E  
S W  
5 miles W of Foxworth  
 (distance) (direction) (nearest town)

WELL PURPOSE: Home  
 (home, irrigation, municipal, industrial)

WELL COMPLETION DATA:

(1) diameter (inches) 2"

(2) total depth (feet) 200

(3) static water level (feet) 100 below top of ground.

(4) casing PVC 190  
 (material) (depth)  
 (size) if telescope see back.

(5) screen 10 190  
 (length) (depth to top)  
2 PVC  
 (size) (material)

(6) pump 1 1/2 8 1/2  
 (HP) (yield gpm)  
elect  
 (type power)

(7) electric log                       
 (yes or no)  
 (organization running log)


(8) how well bottom plugged sand  
SHANK

DRILLERS REMARKS: Good well

MISSISSIPPI  
 DEPARTMENT OF NATURAL RESOURCES  
 BUREAU OF LAND & WATER RESOURCES  
 MAY 13 1981  
**RECEIVED**

If well telescopes please sketch and show depths.

GROUND LEVEL

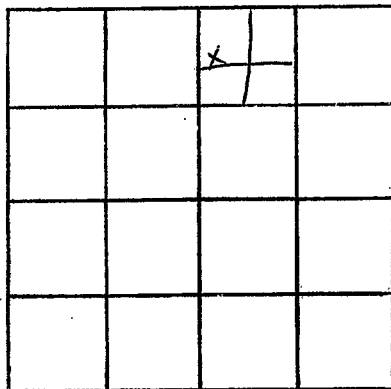

SECTION 9

Please indicate well location X.

ADDITIONAL INFORMATION

If more than one screen, show locations of each on sketch.