

Marion
 J 2011
 5-6-81

MISSISSIPPI
 BOARD OF WATER COMMISSIONERS
 416 North State Street
 Jackson, Mississippi 39201

WATER WELL DRILLERS LOG

5-6 1981 Hollinger MARION
 date well completed firm name county well located

LANDOWNER: Don White
 Hwy 98 W
 Foxworth, MS
 (mailing address)

description of formations encountered	from	to
Red clay	0	30
Mixed sand, gravel	30	70
Gravel	70	105

WELL LOCATION:
 sec. 24 T 30 N R 12 E
 S 7 E
 6 miles W of Foxworth
 (distance) (direction) (nearest town)

WELL PURPOSE: Home
 (home, irrigation, municipal, industrial)

WELL COMPLETION DATA:

- (1) diameter (inches) 2"
- (2) total depth (feet) 105
- (3) static water level (feet) 70 below top of ground.
- (4) casing PVC, 100 (material) (depth)
 (size) If telescope see back.
- (5) screen 5, 100 (length) (depth to top)
 2, PVC (size) (material)
- (6) pump 1, 7 (HP) (yield gpm)
 elect (type power)
- (7) electric log (yes or no)
 (organization running log)

DEPT. OF NATURAL RESOURCES
 BUREAU OF LAND & WATER RESOURCES


MAY 13 1981

RECEIVED

(8) how well bottom plugged sand
 SHANK
 DRILLERS REMARKS: Good well

If well telescopes please sketch and show depths.

GROUND LEVEL

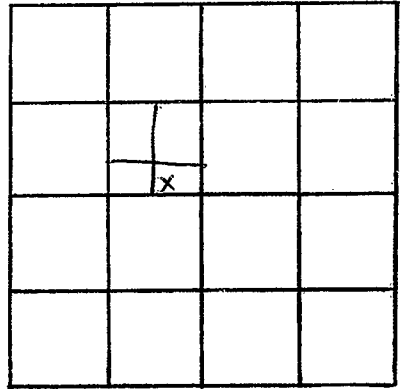

SECTION 24

Please indicate well location X.

ADDITIONAL INFORMATION

If more than one screen,
show locations of each on sketch.