

Marion
 J 2072
 5-10-81

MISSISSIPPI
 BOARD OF WATER COMMISSIONERS
 416 North State Street
 Jackson, Mississippi 39201

WATER WELL DRILLERS LOG

5-10 1981 Hollingsworth Marion
 date well completed firm name county well located

LANDOWNER: J C Lyman
 RT 1
 KOKOMO MS
 (mailing address)

description of formations encountered	from	to
Red clay	0	40
sand, chalk mixed	40	140
pea gravel	140	185

WELL LOCATION:
 sec. 16, 30 N R 120E
 6 miles N of KOKOMO
 (distance) (direction) (nearest town)

WELL PURPOSE: Home
 (home, irrigation, municipal, industrial)

WELL COMPLETION DATA:

(1) diameter (inches) 2

(2) total depth (feet) 185

(3) static water level (feet) 80 below top of ground.

(4) casing PVC 175 (material) (depth)

(size) If telescope see back.

(5) screen 10 175 (length) (depth to top)

2 PVC (size) (material)

(6) pump 1 1/2 8 (HP) (yield gpm)

elect (type power)

(7) electric log (yes or no)

(organization running log)

DEPT. OF NATURAL RESOURCES
 BUREAU OF LAND & WATER RESOURCES

MAY 13 1981


RECEIVED

(8) how well bottom plugged SAND SHANK

DRILLERS REMARKS: Good well

If well telescopes please sketch and show depths.

GROUND LEVEL

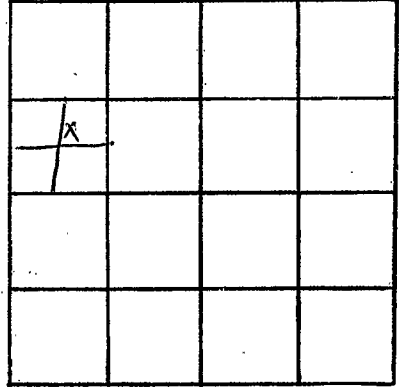

SECTION 18

Please indicate well location X.

ADDITIONAL INFORMATION

Lined area for additional information.

If more than one screen, show locations of each on sketch.