

MARION
J 2073
9-18-80

MISSISSIPPI
 BOARD OF WATER COMMISSIONERS
 416 North State Street
 Jackson, Mississippi 39201

WATER WELL DRILLERS LOG

Marion
~~Marion~~
 county well located

date well completed Sept 18 19 80 Reems well Sec
 firm name


LANDOWNER:
Edward Watson
P.O. Box 8 Columbia
 (mailing address)

description of formations encountered	from to	
<u>Red sandy clay</u>	<u>0</u>	<u>22</u>
<u>Red clay shale</u>	<u>22</u>	<u>70</u>
<u>Sand + gravel</u>	<u>70</u>	<u>90</u>
<u>Clay + sand</u>	<u>90</u>	<u>115</u>
<u>sand + gravel</u>	<u>115</u>	<u>140</u>

WELL LOCATION:
 sec. 35 T 3 N R 12 E
3 miles WSW of Kokomo
 (distance) (direction) (nearest town)

WELL PURPOSE: Home
 (home, irrigation, municipal, industrial)

- WELL COMPLETION DATA:
- (1) diameter (inches) 4"
 - (2) total depth (feet) 140
 - (3) static water level (feet) 116 below top of ground
 - (4) casing plastic bottom
 (material) (depth)
 - _____ if telescope see back.
 (size)
 - (5) screen 5' 135'
 (length) (depth to top)
 - 4' plastic
 (size) (material)
 - (6) pump 3/4" HP 12
 (HP) (yield gpm)
 - split
 (type power)
 - (7) electric log no
 (yes or no)
 - _____ (organization running log)

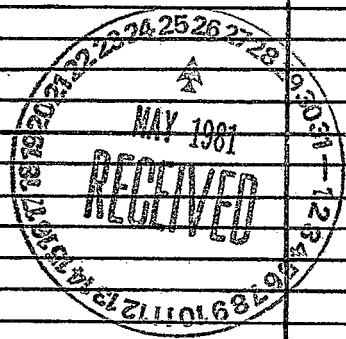

(8) how well bottom plugged Rocky sand & blue

DRILLERS REMARKS:

If well telescopes please
sketch and show depths.

GROUND LEVEL

			1

SECTION 35

Please indicate well location X.

ADDITIONAL INFORMATION

If more than one screen,
show locations of each on sketch.