

Marion  
J 2075  
6-5-81

MISSISSIPPI  
 BOARD OF WATER COMMISSIONERS  
 416 North State Street  
 Jackson, Mississippi 39201

WATER WELL DRILLERS LOG


6-5 1981 Fitzgerald Well Serv Marion  
 date well completed firm name county well located

LANDOWNER:	description of formations encountered	from	to
<u>A. Ross</u>			
<u>R.R. Korman</u> (mailing address)	<u>Red clay</u>	<u>0</u>	<u>20</u>
	<u>Red sand</u>	<u>20</u>	<u>105</u>
	<u>Coarse sand &amp; gravel</u>	<u>105</u>	<u>120</u>

WELL LOCATION:  
 sec. 29 T. 3 N S R. 12 E W  
1 miles W of Korman  
 (distance) (direction) (nearest town)

WELL PURPOSE: Flow  
 (home, irrigation, municipal, industrial)


- WELL COMPLETION DATA:
- diameter (inches) 4
  - total depth (feet) 120
  - static water level (feet) 70 below above top of ground.
  - casing PVC, 112,  
(material) (depth)  
4 If telescope see back.  
(size)
  - screen 8, 112  
(length) (depth to top)  
4, PVC  
(size) (material)
  - pump 1/2 10  
(HP) (yield gpm)  
ELV  
(type power)
  - electric log Y  
(yes or no)  
(organization running log)
  - how well bottom plugged Seal Plug

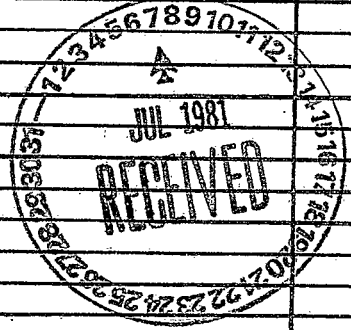

DRILLERS REMARKS:

If well telescopes please sketch and show depths.

GROUND LEVEL

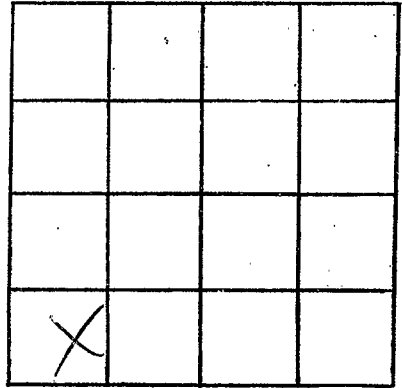

SECTION 29

Please indicate well location X.

ADDITIONAL INFORMATION

If more than one screen,  
show locations of each on sketch.