

MISSISSIPPI DEPARTMENT OF NATURAL RESOURCES

Bureau of Land and Water Resources

Southport Mall

P.O. Box 10631

Jackson, Mississippi 39209

WATER WELL DRILLERS LOG

Marion
J 2076
3-5-81

March 5 19 81 Penner well in Marion
 date well completed firm name county well located

LANDOWNER:
Robert McKenzie
Rt Fairwath
 (mailing address)

description of formations encountered	from to	
<u>Red Clay</u>	<u>0</u>	<u>20</u>
<u>Red sand</u>	<u>20</u>	<u>58</u>
<u>Red Chalk</u>	<u>58</u>	<u>65</u>
<u>soft gravel</u>	<u>65</u>	<u>84</u>
<u>White Chalk</u>	<u>84</u>	<u>130</u>
<u>Coarse sand</u>	<u>130</u>	<u>180</u>

WELL LOCATION:
 sec. 3 T. 3 N. R. 12 E
6 miles west of Fairwath
 (distance) (direction) (nearest town)

WELL PURPOSE: home
 (home, irrigation, municipal, industrial)

WELL COMPLETION DATA:

(1) diameter (inches) 4"

(2) total depth (feet) 180

(3) static water level (feet) 140 below/above top of ground.

(4) casing plastic bottom
 (material) (depth)
 (size) if telescope see back.


(5) screen 5' 175"
 (length) (depth to top)
4" plastic
 (size) (material)

(6) pump 3 sub 12
1/2 (HP) (yield gpm)
West
 (type power)

(7) electric log no
 (yes or no)
 (organization running log)

(8) how well bottom plugged
wash wash

DRILLERS REMARKS:
/

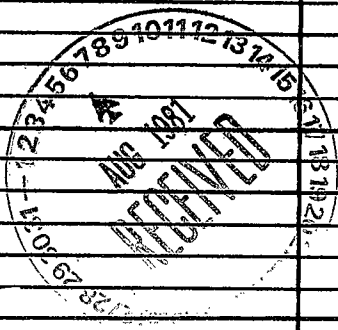

If well telescopes please sketch and show depths.

GROUND LEVEL

		X	

SECTION 3

Please indicate well location X.

ADDITIONAL INFORMATION

If more than one screen, show locations of each on sketch.