

MISSISSIPPI DEPARTMENT OF NATURAL RESOURCES

Bureau of Land and Water Resources

Southport Mall

P.O. Box 10631

Jackson, Mississippi 39209

WATER WELL DRILLERS LOG

Marion
J 2078
4-12-81

April 12 1981

News Well Ser

Marion
~~Waltham~~

date well completed

firm name

county well located

LANDOWNER:

Robert Turnage
Rt Fordworth
(mailing address)

description of formations encountered

from to

<u>Clay & gravel</u>	<u>0</u>	<u>25</u>
<u>Red sand & gravel</u>	<u>25</u>	<u>75</u>
<u>Gravel</u>		
<u>Yellow chalk</u>	<u>75</u>	<u>140</u>
<u>Sand & gravel</u>	<u>140</u>	<u>161</u>

WELL LOCATION:

sec 31 T 3 N R 12 E
4 1/2 miles S of Kokomo
(distance) (direction) (nearest town)

WELL PURPOSE: Trailer
(home, irrigation, municipal, industrial)


WELL COMPLETION DATA:

- (1) diameter (inches) 4"
- (2) total depth (feet) 161
- (3) static water level (feet) 85 below top of ground.
- (4) casing plastic bottom
(material) (depth)
- (5) screen 5' 156
(length) (depth to top)
- (6) pump 4" plastic
(size) (material)
- (7) pump 1/2 10
(HP) (yield gpm)
- (8) electric log no
(yes or no)

(organization running log)


(8) how well bottom plugged back and

DRILLERS REMARKS:

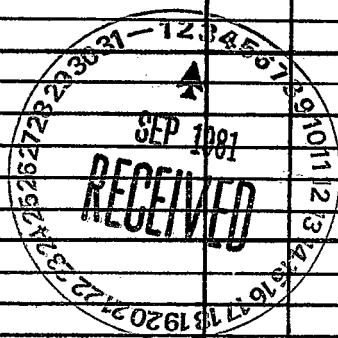

If well telescopes please sketch and show depths.

GROUND LEVEL

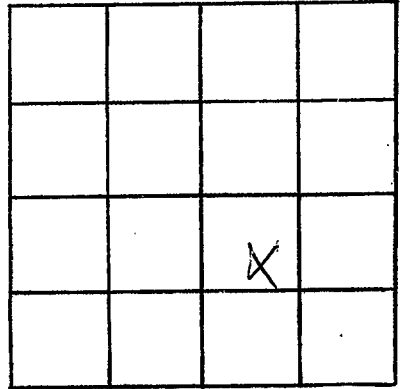

SECTION 31

Please indicate well location X.

ADDITIONAL INFORMATION

If more than one screen, show locations of each on sketch.