

MISSISSIPPI DEPARTMENT OF NATURAL RESOURCES

Bureau of Land and Water Resources

Southport Mall

P.O. Box 10631

Jackson, Mississippi 39209

WATER WELL DRILLERS LOG

Marion
J 2079
5-8-81

May 8 1981 Reyes Miller Marion
date well completed firm name county well located

LANDOWNER:
Mr. Maude Pittman
Rt. Kombo
(mailing address)

description of formations encountered	from	to
<u>Clay</u>	<u>0</u>	<u>12</u>
<u>White sand</u>	<u>12</u>	<u>50</u>
<u>Coarse sand & silt</u>	<u>50</u>	<u>73</u>
<u>fine gravel</u>		

WELL LOCATION:
sec. 3 T-3 N R-12 E
6 1/2 miles WNW of Fayette
(distance) (direction) (nearest town)

WELL PURPOSE: home
(home, irrigation, municipal, industrial)

WELL COMPLETION DATA:
(1) diameter (inches) 4 1/2"
(2) total depth (feet) 73
(3) static water level (feet) 15 below top of ground
(4) casing Plastic Cotton
(material) (depth)
1 if telescope see back.
(5) screen 5' 68'
(length) (depth to top)
4" Plastic
(size) (material)
(6) pump 1/2 10
(HP) (yield gpm)
elect
(type power)
(7) electric log no
(yes or no)
1
(organization running log)

(8) how well bottom plugged
Back wash valve

DRILLERS REMARKS:
2" well sanding off


DEPT. OF NATURAL RESOURCES
BUREAU OF LAND & WATER RESOURCES

OCT - 1 1981

RECEIVED

If well telescopes please sketch and show depths.

GROUND LEVEL

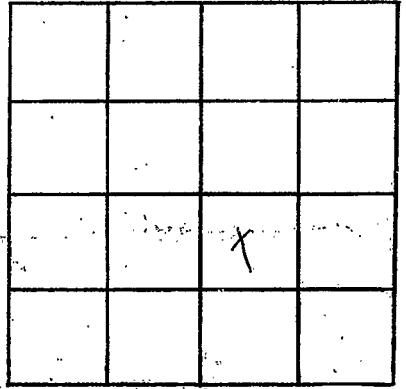

SECTION 3

Please indicate well location X.

ADDITIONAL INFORMATION

If more than one screen, show locations of each on sketch.