

Marion
T 2080
7-9-81

MISSISSIPPI
 BOARD OF WATER COMMISSIONERS
 416 North State Street
 Jackson, Mississippi 39201

WATER WELL DRILLERS LOG

7-9 1981 Holliston Marion
 date well completed firm name county well located

LANDOWNER: Erma J Smith
Little Rock Cove
Foxworth, MS
 (mailing address)

description of formations encountered	from	to
<u>Sand, Chalk, & gravel</u>	<u>0</u>	<u>120</u>
<u>Chalk</u>	<u>120</u>	<u>150</u>
<u>pea gravel</u>	<u>150</u>	<u>185</u>

WELL LOCATION:
 sec 10 T 3 (N) R 12 (E)
H 5 1/2 miles W of Foxworth
 (distance) (direction) (nearest town)

WELL PURPOSE:
 (home, irrigation, municipal, industrial)


- WELL COMPLETION DATA:
- (1) diameter (inches) 2
 - (2) total depth (feet) 185
 - (3) static water level (feet) 100 below top of ground.
 - (4) casing PVC (material), (depth) _____
 (size) _____ If telescope see back.
 - (5) screen 5 (length), (depth to top) _____
2 (size), PVC (material)
 - (6) pump 1 1/2 (HP), 8 (yield gpm)
elect (type power)
 - (7) electric log (yes or no) _____
 (organization running log) _____
 - (8) how well bottom plugged sand
stone

DRILLERS REMARKS: good well

DEPT. OF NATURAL RESOURCES
 BUREAU OF LAND & WATER RESOURCES


AUG 20 1981

RECEIVED

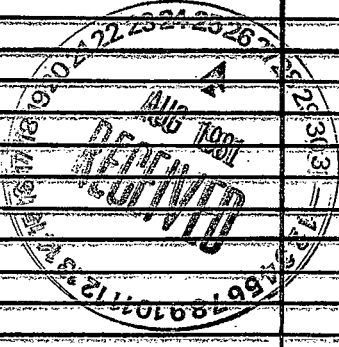

If well telescopes please sketch and show depths.

GROUND LEVEL

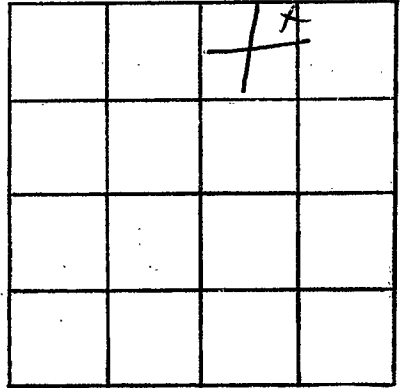

SECTION 10

Please indicate well location X.

ADDITIONAL INFORMATION

Multiple horizontal lines for additional information.

If more than one screen, show locations of each on sketch.