

MARION  
 J 2084  
 7-22-81

MISSISSIPPI  
 BOARD OF WATER COMMISSIONERS  
 416 North State Street  
 Jackson, Mississippi 39201

WATER WELL DRILLERS LOG

7-22-81 19 Tom Griffith Well serv MARION  
 date well completed well name county well located

LANDOWNER:  
Elba Daniels  
Rt 1 Box 318 Fox  
 (mailing address)

description of formations encountered	from	to
top soil	0	3
Red Clay	3	15
Br & Sand	15	45
Clay	45	100
Sand	100	160

WELL LOCATION: 12 E  
 sec. 2 T. 3 N R. 20 E  
4 miles West of Fox  
 (distance) (direction) (nearest town)

WELL PURPOSE: Home  
 (home, irrigation, municipal, industrial)

WELL COMPLETION DATA:

- (1) diameter (inches) 2
- (2) total depth (feet) 160 Feet
- (3) static water level (feet) 100 below top of ground.
- (4) casing Steel 160  
 (material) (depth)  
 (size) if telescope see back.
- (5) screen 20 Feet 160 - 140  
 (length) (depth to top)  
2 - Steel  
 (size) (material)
- (6) pump 2 3 hp  
 (HP) (yield gpm)  
 (type power)
- (7) electric log No  
 (yes or no)  
M/A  
 (organization running log)
- (8) how well bottom plugged D, W, Y, I

DEPT. OF NATURAL RESOURCES  
 BUREAU OF LAND & WATER RESOURCES


OCT 20 1981

RECEIVED

DRILLERS REMARKS:

If well telescopes please sketch and show depths.

GROUND LEVEL

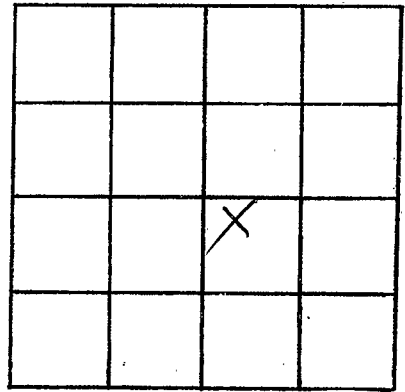

SECTION 2

Please indicate well location X.

ADDITIONAL INFORMATION

If more than one screen, show locations of each on sketch.