

MARION  
 J 2085  
 1981

MISSISSIPPI  
 BOARD OF WATER COMMISSIONERS  
 416 North State Street  
 Jackson, Mississippi 39201

WATER WELL DRILLERS LOG

19 Tom Griffith Well Serv. Marion  
 date well completed firm name county well located

LANDOWNER: Cassie Holmes  
Rt. 1, Box 237  
Kokomo Miss.  
 (mailing address)

description of formations encountered	from	to
<u>top soil</u>	<u>0</u>	<u>4</u>
<u>Red sand</u>	<u>4</u>	<u>10</u>
<u>Clay</u>	<u>10</u>	<u>20</u>
<u>sand</u>	<u>20</u>	<u>60</u>
<u>Clay</u>	<u>60</u>	<u>95</u>
<u>Sand</u>	<u>95</u>	<u>130</u>

WELL LOCATION:  
 sec. 24 T 3 N R. 12 E  
4 miles West of Foxworth  
 (distance) (direction) (nearest town)

WELL PURPOSE: Home  
 (home, irrigation, municipal, industrial)

- WELL COMPLETION DATA:
- (1) diameter (inches) 2 in
  - (2) total depth (feet) 130 feet
  - (3) static water level (feet) 95 below top of ground.
  - (4) casing Plastic ~~110~~  
 (material) (depth)
  - (size) if telescope see back.
  - (5) screen 20 feet 110  
 (length) (depth to top)
  - 2 in Plastic  
 (size) (material)
  - (6) pump 1 10  
 (HP) (yield gpm)
  - EP  
 (type power)
  - (7) electric log no  
 (yes or no)
  - n/a  
 (organization running log)
  - (8) how well bottom plugged B.W.V.

DEPT. OF NATURAL RESOURCES  
 BUREAU OF LAND & WATER RESOURCES


OCT 20 1981

RECEIVED

DRILLERS REMARKS:

If well telescopes please sketch and show depths.

GROUND LEVEL

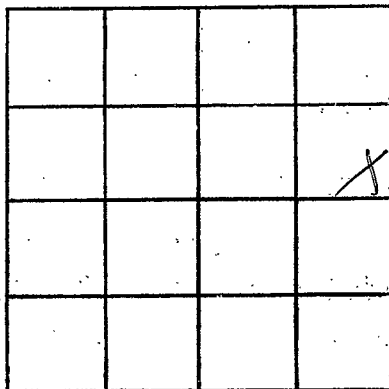

SECTION 24

Please indicate well location X.

ADDITIONAL INFORMATION

Lined area for additional information.

If more than one screen, show locations of each on sketch.