

Marion  
 J 2086  
 8-24-81

MISSISSIPPI  
 BOARD OF WATER COMMISSIONERS  
 416 North State Street  
 Jackson, Mississippi 39201

WATER WELL DRILLERS LOG

8-24-81 19 Tom Griffith Well Serv, Marion  
 date well completed firm name county well located

LANDOWNER: P.O. Box 75  
 Earl Summer  
 Kokomo Miss  
 (mailing address)

description of formations encountered	from	to
top soil	0	3
Clay	3	15
Red sand	15	35
White Sand	35	120

WELL LOCATION:  
 sec. 20 T 3 N R 12 E  
 1 miles north of Kokomo  
 (distance) (direction) (nearest town)

WELL PURPOSE: Home  
 (home, irrigation, municipal, industrial)

- WELL COMPLETION DATA:
- (1) diameter (inches) 2"
  - (2) total depth (feet) 120 feet
  - (3) static water level (feet) 65' below top of ground.
  - (4) casing pipe, 120 feet (material) (depth)
  - (size) if telescope see back.
  - (5) screen 2" 120-100 (length) (depth to top)  
 2" pipe (size) (material)
  - (6) pump 1 (HP) 10 (yield gpm)  
 gear (type power)
  - (7) electric log no (yes or no)  
 n/a (organization running log)
  - (8) how well bottom plugged B, W, D

DEPT. OF NATURAL RESOURCES  
 BUREAU OF LAND & WATER RESOURCES


OCT 20 1981

RECEIVED

DRILLERS REMARKS:

If well telescopes please sketch and show depths.

GROUND LEVEL

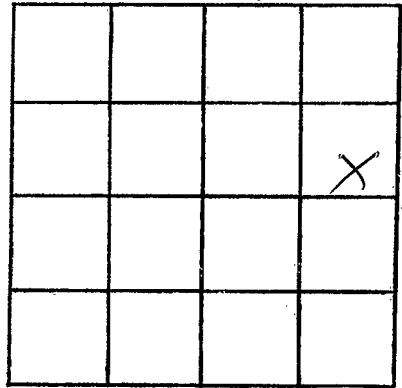

SECTION 20

Please indicate well location X.

ADDITIONAL INFORMATION

If more than one screen,  
show locations of each on sketch.