

MISSISSIPPI DEPARTMENT OF NATURAL RESOURCES

Bureau of Land and Water Resources

Southport Mall

P.O. Box 10631

Jackson, Mississippi 39209

WATER WELL DRILLERS LOG

<u>Marion</u>
<u>J</u>
<u>2087</u>

5-27-82 1982 Hollinger Marion
 date well completed firm name county well located

LANDOWNER:	description of formations encountered	from	to
<u>Charles W. Oden</u>			
<u>Rt. 1</u>			
<u>Foxworth, Mo.</u> (mailing address)	<u>Clay</u>	<u>0</u>	<u>30</u>
	<u>Chalk, sand</u>	<u>30</u>	<u>60</u>
	<u>Coarse sand, gravel</u>	<u>60</u>	<u>105</u>
WELL LOCATION:			
sec. <u>11</u> T. <u>30</u> N. R. <u>20</u> E.			
S <u>6</u> miles <u>W</u> of <u>Foxworth</u>			
(distance) (direction) (nearest town)			
WELL PURPOSE:			
(home, irrigation, municipal, industrial)			
WELL COMPLETION DATA:			
(1) diameter (inches) <u>2</u>			
(2) total depth (feet) <u>105</u>			
(3) static water level (feet) <u>60</u> <u>below</u> top of ground.			
(4) casing <u>PVC</u> , <u>105</u> , (material) (depth)			
<u> </u> If telescope see back. (size)			
(5) screen <u>5</u> , <u>100</u> (length) (depth to top)			
<u>2</u> , <u>PVC</u> (size) (material)			
(6) pump <u>1</u> <u>60</u> (HP) (yield gpm)			
<u>elect.</u> (type power)			
(7) electric log <u> </u> (yes or no)			
<u> </u> (organization running log)			
(8) how well bottom plugged <u>sand</u> <u>shark</u>			
DRILLERS REMARKS: <u>good</u> <u>well</u>			

copy


DEPT. OF NATURAL RESOURCES
BUREAU OF LAND & WATER RESOURCES

NOV 17 1982

RECEIVED

If well telescopes please sketch and show depths.

GROUND LEVEL

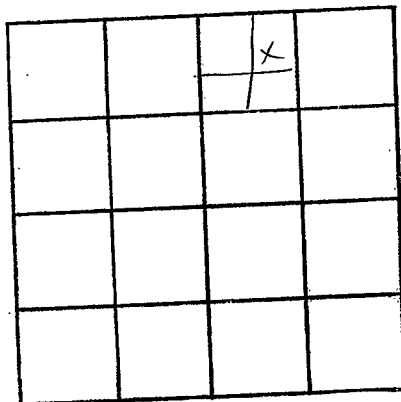

SECTION 11

Please indicate well location X.

ADDITIONAL INFORMATION

If more than one screen, show locations of each on sketch.