

MISSISSIPPI DEPARTMENT OF NATURAL RESOURCES

Bureau of Land and Water Resources

Southport Mall

P.O. Box 10631

Jackson, Mississippi 39209

WATER WELL DRILLERS LOG

TOM GRIFFITH

PLUMBING & WELL SERVICE, INC.

Marion

Marion
J
2088

11-26 1982
date well completed

721A MAYSON AVE.
COLUMBIA, MS 39420

county well located

LANDOWNER: <i>Alberta Lewis</i>	description of formations encountered	from	to
<i>172</i> <i>Fordwell, Miss</i> (mailing address)	Sand	1'	20'
WELL LOCATION: sec. <i>4</i> T <i>3</i> N R <i>12</i> E S W	Chalk	20'	110'
<i>10</i> miles <i>W</i> of <i>Fordwell</i> (distance) (direction) (nearest town)	Pea-Gravel	110'	190'
WELL PURPOSE: <i>House</i> (home, irrigation, municipal, industrial)			
WELL COMPLETION DATA:			
(1) diameter (inches) <i>2"</i>			
(2) total depth (feet) <i>190'</i>			
(3) static water level (feet) <i>130</i> below top of ground.			
(4) casing <i>PVC</i> , <i>190'</i> (material) (depth)			
<i>N/A</i> if telescope see back. (size)			
(5) screen <i>20'</i> , <i>190'</i> (length) (depth to top)			
<i>2"</i> , <i>PVC</i> (size) (material)			
(6) pump <i>2</i> <i>10</i> (HP) (yield gpm)			
<i>elec.</i> (type power)			
(7) electric log <i>none</i> (yes or no)			
<i>N/A</i> (organization running log)			
(8) how well bottom plugged <i>BWU</i>			

DEPT. OF NATURAL RESOURCES
BUREAU OF LAND & WATER RESOURCES


MAR - 9 1983

RECEIVED

DRILLERS REMARKS:

If well telescopes please sketch and show depths.

GROUND LEVEL

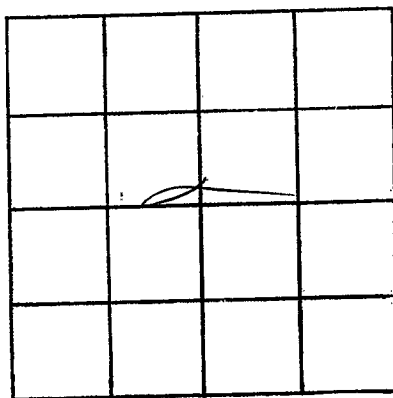

SECTION _____

Please indicate well location X.

ADDITIONAL INFORMATION

If more than one screen,
show locations of each on sketch.