

MISSISSIPPI DEPARTMENT OF NATURAL RESOURCES
 Bureau of Land and Water Resources
 Southport Mall
 P.O. Box 10631
 Jackson, Mississippi 39209
WATER WELL DRILLERS LOG

Marion
J
2090

3-15 1984 FITZGEROLD Well Serv MARION
 date well completed firm name county well located

LANDOWNER:	description of formations encountered	from	to
<u>MAST DAIRY</u> <u>R.R. Foxworth MS.</u> (mailing address)	<u>Red Clay</u>	<u>0</u>	<u>20</u>
	<u>Red SAND</u>	<u>20</u>	<u>100</u>
	<u>COURSE SAND & GRAVEL</u>	<u>100</u>	<u>112</u>
WELL LOCATION: sec. <u>3</u> T. <u>3</u> N R. <u>12</u> E S W <u>#</u> miles <u>SE</u> of <u>DARBUN</u> (distance) (direction) (nearest town)			
WELL PURPOSE: <u>Home</u> (home, irrigation, municipal, industrial)			
WELL COMPLETION DATA: (1) diameter (inches) <u>4</u> (2) total depth (feet) <u>112</u> (3) static water level (feet) <u>65</u> below above top of ground. (4) casing <u>PVC</u> , <u>164</u> , (material) (depth) <u>4</u> if telescope see back. (size) (5) screen <u>8</u> , <u>164</u> (length) (depth to top) <u>4</u> , <u>20 C</u> (size) (material) (6) pump <u>1/2</u> , <u>10</u> (HP) (yield gpm) <u>elec</u> (type power) (7) electric log <u>no</u> (yes or no) (organization running log) (8) how well bottom plugged <u>Sealed</u>			
DRILLERS REMARKS:			


DEPT. OF NATURAL RESOURCES
 BUREAU OF LAND & WATER RESOURCES

APR 26 1984

RECEIVED

If well telescopes please sketch and show depths.

GROUND LEVEL

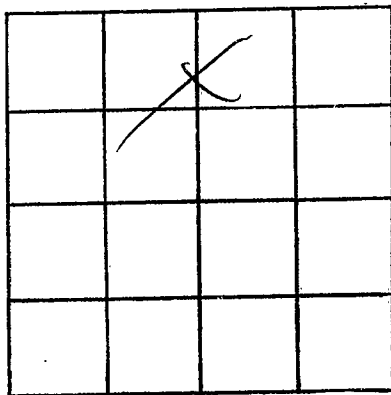

SECTION 3

Please indicate well location X.

ADDITIONAL INFORMATION

If more than one screen,
show locations of each on sketch.