

Maion  
 8  
 2091

MISSISSIPPI DEPARTMENT OF NATURAL RESOURCES  
 Bureau of Land and Water Resources  
 Southport Mall  
 P.O. Box 10631  
 Jackson, Mississippi 39209  
**WATER WELL DRILLERS LOG**

11-9 1984 ADLinsen MAKION  
 date well completed firm name county well located

LANDOWNER: Willie C. Taylor  
Hwy 98 W Rt 2  
Foxworth Yms  
 (mailing address)

description of formations encountered	from	to
<u>sand &amp; gravel</u>	<u>0</u>	<u>50</u>
<u>Clay</u>	<u>50</u>	<u>100</u>
<u>Sand, per gravel</u>	<u>100</u>	<u>124</u>

WELL LOCATION:  
 sec. 24 T 3 (N) R. 20 (E)  
1 miles E of Kokomo  
 (distance) (direction) (nearest town)

WELL PURPOSE:  
 (home, irrigation, municipal, industrial)

WELL COMPLETION DATA:

- (1) diameter (inches) 4"
- (2) total depth (feet) 124
- (3) static water level (feet) \_\_\_\_\_ below above top of ground.
- (4) casing PVC (material) \_\_\_\_\_ (depth) \_\_\_\_\_  
 \_\_\_\_\_ if telescope see back.  
 (size)
- (5) screen 10 \_\_\_\_\_ 114 \_\_\_\_\_  
 (length) (depth to top)  
4 \_\_\_\_\_ PVC \_\_\_\_\_  
 (size) (material)
- (6) pump 1 \_\_\_\_\_ 11 \_\_\_\_\_  
 (HP) (yield gpm)  
elect \_\_\_\_\_  
 (type power)
- (7) electric log \_\_\_\_\_ (yes or no)  
 \_\_\_\_\_ (organization running log)
- (8) how well bottom plugged Sand  
SMARK

DRILLERS REMARKS: good well


DEPT. OF NATURAL RESOURCES  
 BUREAU OF LAND & WATER RESOURCES

NOV 20 1984

RECEIVED

If well telescopes please sketch and show depths.

GROUND LEVEL

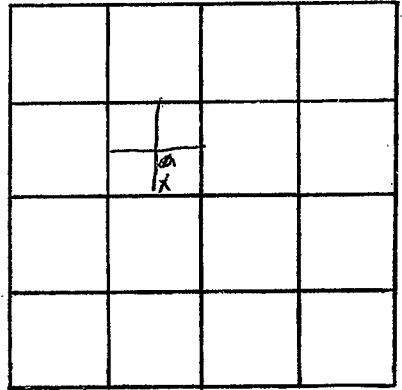

SECTION 24

Please indicate well location X.

ADDITIONAL INFORMATION

If more than one screen,  
show locations of each on sketch.