

MISSISSIPPI DEPARTMENT OF ENVIRONMENTAL QUALITY
Bureau of Land and Water Resources

P. O. Box 10631
Jackson, MS 39289-0631
WATER WELL DRILLERS LOG

COUNTY WELL LOCATED MARION	
WELL NUMBER 2095	CODED
DATE WELL COMPLETED Jan 27-92	

PERMIT NUMBER
NAME OF DRILLING FIRM FITZGERALD Well Serv

NAME & MAILING ADDRESS OF LANDOWNER Roy McMAHOS	
RR. Foyworth, MS	
WELL LOCATION: SEC 14 TOWNSHIP 3 RANGE N 12 E	
DISTANCE 5 Miles WNW of Foyworth	DIRECTION NEAREST TOWN
OTHER LANDMARK	
WELL PURPOSE: Home, Irrigation, Municipal, Industrial, Fish Pond, etc. Home	

PUMP DATA		
PUMP TYPE (Circle One): <input checked="" type="radio"/> Submersible Turbine Jet Flowing Well, Other (Describe) _____		
POWER TYPE (Circle One): <input checked="" type="radio"/> Electric Tractor, Diesel, Gasoline, Butane, Other (Describe) _____ H/P 12		
Pump Capacity (GPM) 10	No. of Stages 8	Setting Depth 55 FT.
PUMP TEST		
Well yielded 20 GPM with a drawdown of 2 ft. after 2 hours of pumping		

WELL DATA		
Well Depth 85	Casing Diameter (In.) 4	Casing Length (Ft.) 75
Type of Casing PUC	Hole Depth 85	Depth to Static Water Level 28
TYPE OF COMPLETION: (Circle One or More): <input checked="" type="radio"/> Gravel Packed, Underreamed, Telescoped, Natural Development, Open Hole, Other (Describe) _____		
Top of Lap Pipe or Reduction in Casing FEET IF TELESCOPED OR MORE THAN ONE SCREEN: USE BACK PAGE		

LOG DATA	
TYPE OF LOG RUN (Circle One): Electric, Gamma Ray, Density, Sonic, Neutron, Other (Describe) _____ No Log Run	
Name of Organization Running Log	

SCREEN DATA		
Diameter - Inches 4	Length - Feet 10	Slot Size - Inches .014
Screen Type PUC	Depth to Bottom - Feet 85	

GEOLOGIC DATA (Office Use Only)			
Surface Elev.	Geologic Unit	Unit Thickness	Depth to Top
Subs. SWL	Date	Analysis	Aquifer Test


Driller's Remarks

DESCRIPTION OF FORMATIONS ENCOUNTERED	FROM	TO	FORMATIONS (Continued)	FROM	TO
Red Clay	0	10			
Red Sand	10	50			
Coarse Sand & gravel	50	85			

IF MORE SPACE IS NEEDED, USE BACK

If well telescopes please
sketch and show depths.

GROUND LEVEL

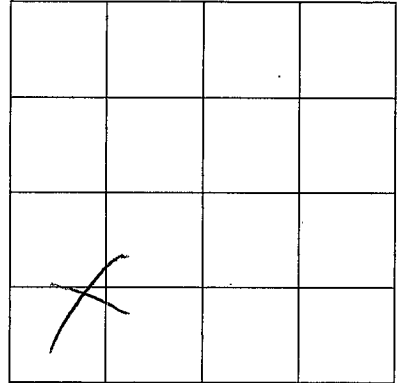

SECTION 14

Please indicate well location X.

ADDITIONAL INFORMATION

If more than one screen,
show location of each on sketch.