

**MISSISSIPPI DEPARTMENT OF ENVIRONMENTAL QUALITY**

Office of Land and Water Resources

P. O. Box 10631  
Jackson, MS 39289-0631  
**WATER WELL DRILLERS LOG**

COUNTY WELL LOCATED <i>MARION</i>	
WELL NUMBER <i>J 2099</i>	CODED
DATE WELL COMPLETED <i>Aug 30 93</i>	

PERMIT NUMBER
NAME OF DRILLING FIRM <i>F. T. GERMID Well Serv</i>

NAME & MAILING ADDRESS OF LANDOWNER <i>Bennie Holmes</i> <i>RR. Kokomo ms -</i>			
WELL LOCATION:	SEC <i>7</i>	TOWNSHIP <i>3 N</i>	RANGE <i>12 E</i>
DISTANCE <i>3</i> Miles	DIRECTION <i>S</i>	NEAREST TOWN <i>DARLINGTON</i>	
OTHER LANDMARK			
WELL PURPOSE: Home, Irrigation, Municipal, Industrial, Fish Pond, etc. <i>Poultry House</i>			


PUMP DATA		
PUMP TYPE (Circle One): <input checked="" type="checkbox"/> Submersible, <input type="checkbox"/> Turbine, <input type="checkbox"/> Jet, <input type="checkbox"/> Flowing Well, Other (Describe) _____		
POWER TYPE (Circle One): <input checked="" type="checkbox"/> Electric, <input type="checkbox"/> Tractor, <input type="checkbox"/> Diesel, <input type="checkbox"/> Gasoline, <input type="checkbox"/> Butane, Other (Describe) _____ H/P <i>1</i>		
Pump Capacity (GPM) <i>20</i>	No. of Stages <i>10</i>	Setting Depth <i>120</i> FT.
PUMP TEST		
Well yielded <i>40</i> GPM with a drawdown of <i>2</i> ft. after <i>2</i> hours of pumping		

WELL DATA		
Well Depth <i>170</i>	Casing Diameter (In.) <i>4</i>	Casing Length (Ft.) <i>160</i>
Type of Casing <i>PVC</i>	Hole Depth <i>170</i>	Depth to Static Water Level <i>82</i>
TYPE OF COMPLETION: (Circle One or More): <input checked="" type="checkbox"/> Gravel Packed, <input type="checkbox"/> Underreamed, <input type="checkbox"/> Telescoped, <input type="checkbox"/> Natural Development, <input type="checkbox"/> Open Hole, <input type="checkbox"/> Other (Describe) _____		
WELL GROUTED TO A DEPTH OF <i>60</i> FEET Type Grout (circle one): Cement, Bentonite, <input checked="" type="checkbox"/> Mix		

LOG DATA	
TYPE OF LOG RUN (Circle One): <input checked="" type="checkbox"/> No Log Run, <input type="checkbox"/> Electric, <input type="checkbox"/> Gamma Ray, <input type="checkbox"/> Density, <input type="checkbox"/> Sonic, <input type="checkbox"/> Neutron, Other (Describe) _____	
Name of Organization Running Log	

SCREEN DATA		
Diameter - Inches <i>4</i>	Length - Feet <i>10</i>	Slot Size - Inches <i>.014</i>
Screen Type <i>PVC</i>		Depth to Bottom - Feet <i>170</i>


GEOLOGIC DATA (Office Use Only)			
Surface Elev.	Geologic Unit	Unit Thickness	Depth to Top
Subs. SWL	Date	Analysis	Aquifer Test
Driller's Remarks			

DESCRIPTION OF FORMATIONS ENCOUNTERED	FROM	TO	FORMATIONS (Continued)	FROM	TO
<i>Red Clay</i>	<i>0</i>	<i>20</i>	 <b>OCT 18 1993</b> Dept. of Environmental Quality Office of Land & Water Resources		
<i>Red Sand</i>	<i>20</i>	<i>90</i>			
<i>White Clay</i>	<i>90</i>	<i>140</i>			
<i>Course Sand</i>	<i>140</i>	<i>170</i>			

IF MORE SPACE IS NEEDED, USE BACK

If well telescopes please sketch and show depths.

GROUND LEVEL

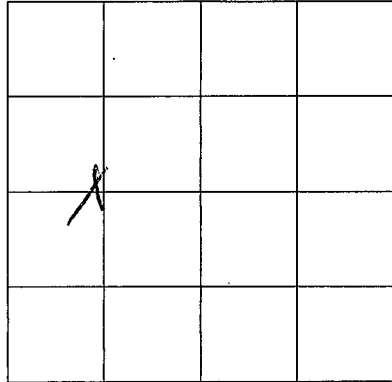

SECTION 7

Please indicate well location X.

ADDITIONAL INFORMATION

If more than one screen,  
show location of each on sketch.