

MARION

MISSISSIPPI DEPARTMENT OF ENVIRONMENTAL QUALITY

Office of Land and Water Resources

P. O. Box 10631

Jackson, MS 39289-0631

WATER WELL DRILLERS LOG

COUNTY WELL LOCATED
Waltham

WELL NUMBER J 2102 CODED

DATE WELL COMPLETED
Nov 22-93

PERMIT NUMBER

NAME OF DRILLING FIRM
Fitzgerald Well Serv

NAME & MAILING ADDRESS OF LANDOWNER
JACK STEVENSON -
RR. Kokomo, ms -

WELL LOCATION: SEC 32 TOWNSHIP 3 RANGE N 12 W

DISTANCE 1 Miles DIRECTION W of NEAREST TOWN Kokomo

OTHER LANDMARK

WELL PURPOSE: Home, Irrigation, Municipal, Industrial, Fish Pond, etc.
Poultry house

PUMP DATA

PUMP TYPE (Circle One):
Submersible, Turbine, Jet, Flowing Well,
Other (Describe)

POWER TYPE (Circle One):
Electric, Tractor, Diesel, Gasoline, Butane,
Other (Describe) H/P 2

Pump Capacity (GPM) 35 No. of Stages 14 Setting Depth 110 FT.

PUMP TEST

Well yielded 50 GPM with
a drawdown of 4 ft.
after 2 hours of pumping

WELL DATA

Well Depth <u>210</u>	Casing Diameter (in.) <u>4</u>	Casing Length (Ft.) <u>190</u>
Type of Casing <u>pvc</u>	Hole Depth <u>210</u>	Depth to Static Water Level <u>56</u>

TYPE OF COMPLETION: (Circle One or More):
Gravel Packed, Underreamed, Telescoped,
Natural Development, Open Hole, Other

LOG DATA

TYPE OF LOG RUN (Circle One):
Electric, Gamma Ray, Density, No Log Run,
Sonic, Neutron,
Other (Describe)

Name of Organization Running Log

WELL GROUTED TO A DEPTH OF 60 FEET
Type Grout (circle one): Cement, Bentonite, or Mix

GEOLOGIC DATA (Office Use Only)

Surface Elev.	Geologic Unit	Unit Thickness	Depth to Top
Subs. SWL	Date	Analysis	Aquifer Test

SCREEN DATA

Diameter - Inches <u>4</u>	Length - Feet <u>20</u>	Slot Size - Inches <u>.014</u>
Screen Type <u>pvc</u>	Depth to Bottom - Feet <u>210</u>	

Driller's Remarks

DESCRIPTION OF FORMATIONS ENCOUNTERED	FROM	TO	FORMATIONS (Continued)	FROM	TO
<u>Red Clay</u>	<u>0</u>	<u>20</u>	RECEIVED		
<u>Red Sand</u>	<u>20</u>	<u>185</u>			
<u>Coarse Sand & gravel</u>	<u>185</u>	<u>210</u>			


JAN 05 1994

Dept. of Environmental Quality
Office of Land & Water Resources

IF MORE SPACE IS NEEDED, USE BACK

If well telescopes please sketch and show depths.

GROUND LEVEL

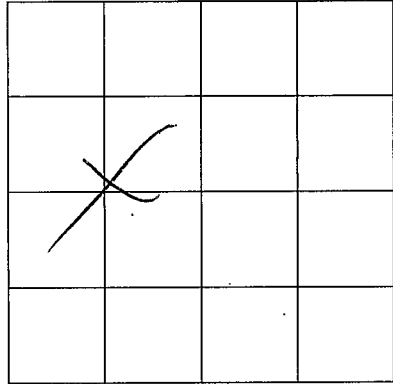

SECTION 32

Please indicate well location X.

ADDITIONAL INFORMATION

If more than one screen,
show location of each on sketch.