

MISSISSIPPI DEPARTMENT OF ENVIRONMENTAL QUALITY

Office of Land and Water Resources

P. O. Box 10631  
Jackson, MS 39289-0631  
WATER WELL DRILLERS LOG

COUNTY WELL LOCATED <i>MAZ:04</i>	
WELL NUMBER <i>J 208</i>	CODED
DATE WELL COMPLETED <i>Oct 19 - 93</i>	

PERMIT NUMBER
NAME OF DRILLING FIRM <i>Fitzgerald Well Serv</i>

NAME & MAILING ADDRESS OF LANDOWNER <i>James Regan</i>			
<i>RR - Kokomo MS -</i>			
WELL LOCATION:	SEC	TOWNSHIP	RANGE
	<i>27</i>	<i>3</i>	<i>N 12 E</i>
DISTANCE	DIRECTION	NEAREST TOWN	
<i>1/2</i> Miles	<i>E</i>	of <i>Kokomo</i>	
OTHER LANDMARK			
WELL PURPOSE: Home, Irrigation, Municipal, Industrial, Fish Pond, etc. <i>TRAILER PARK</i>			


PUMP DATA		
PUMP TYPE (Circle One): <input checked="" type="checkbox"/> Submersible, <input type="checkbox"/> Turbine, <input type="checkbox"/> Jet <input type="checkbox"/> Flowing Well, Other (Describe) _____		
POWER TYPE (Circle One): <input checked="" type="checkbox"/> Electric, <input type="checkbox"/> Tractor, <input type="checkbox"/> Diesel, <input type="checkbox"/> Gasoline, <input type="checkbox"/> Butane, Other (Describe) _____ H/P <i>1</i>		
Pump Capacity (GPM) <i>20</i>	No. of Stages <i>14</i>	Setting Depth <i>165</i> FT.
PUMP TEST		
Well yielded <i>40</i> GPM with a drawdown of <i>4</i> ft. after <i>2</i> hours of pumping		

WELL DATA		
Well Depth <i>218</i>	Casing Diameter (In.) <i>4</i>	Casing Length (Ft.) <i>208</i>
Type of Casing <i>PVC</i>	Hole Depth <i>218</i>	Depth to Static Water Level <i>120</i>
TYPE OF COMPLETION: (Circle One or More): <input checked="" type="checkbox"/> Gravel Packed, <input type="checkbox"/> Underreamed, <input type="checkbox"/> Telescoped, <input type="checkbox"/> Natural Development, <input type="checkbox"/> Open Hole, <input type="checkbox"/> Other (Describe) _____		
WELL GROUTED TO A DEPTH OF <i>10</i> FEET Type Grout (circle one): Cement, Bentonite, <input checked="" type="checkbox"/> Mix		

LOG DATA	
TYPE OF LOG RUN (Circle One): <input type="checkbox"/> Electric, <input type="checkbox"/> Gamma Ray, <input type="checkbox"/> Density, <input type="checkbox"/> Sonic, <input type="checkbox"/> Neutron, Other (Describe) _____	
Name of Organization Running Log <i>No Log Run</i>	

SCREEN DATA		
Diameter - Inches <i>4</i>	Length - Feet <i>10</i>	Slot Size - Inches <i>1014</i>
Screen Type <i>PVC</i>	Depth to Bottom - Feet <i>218</i>	


GEOLOGIC DATA (Office Use Only)			
Surface Elev.	Geologic Unit	Unit Thickness	Depth to Top
Subs. SWL	Date	Analysis	Aquifer Test
Driller's Remarks			

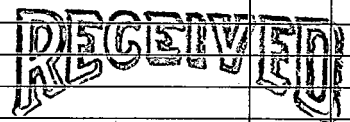DESCRIPTION OF FORMATIONS ENCOUNTERED	FROM	TO	FORMATIONS (Continued)	FROM	TO
<i>Red Clay</i>	<i>0</i>	<i>20</i>	 <b>JAN 05 1994</b> Dept. of Environmental Quality Office of Land & Water Resources		
<i>Red Sand</i>	<i>20</i>	<i>107</i>			
<i>White Chalky</i>	<i>107</i>	<i>197</i>			
<i>Coarse Sand</i>	<i>197</i>	<i>218</i>			

IF MORE SPACE IS NEEDED, USE BACK

If well telescopes please  
sketch and show depths.

GROUND LEVEL

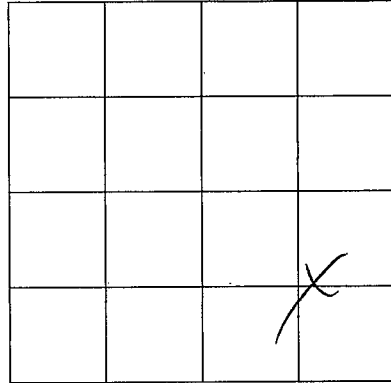

SECTION 27

Please indicate well location X.

ADDITIONAL INFORMATION

If more than one screen,  
show location of each on sketch.