

**MISSISSIPPI DEPARTMENT OF ENVIRONMENTAL QUALITY**  
Bureau of Land and Water Resources

P. O. Box 10631  
Jackson, MS 39289-0631  
**WATER WELL DRILLERS LOG**

COUNTY WELL LOCATED <b>Marion</b>	
WELL NUMBER <b>J 2104</b>	CODED
DATE WELL COMPLETED <b>4/19/94</b>	

PERMIT NUMBER <b>0-508</b>
NAME OF DRILLING FIRM <b>Jordan Well Ser.</b>

NAME & MAILING ADDRESS OF LANDOWNER <b>DALE COVERLY</b> <b>Kokomo, Miss.</b>			
WELL LOCATION: SEC	TOWNSHIP	RANGE	
<b>4</b>	<b>3</b>	<b>N</b>	<b>12<sup>E</sup></b>
		<b>S</b>	<b>W</b>
DISTANCE <b>8</b> Miles	DIRECTION <b>E</b>	NEAREST TOWN <b>Telestown</b>	
OTHER LANDMARK			
WELL PURPOSE: <input checked="" type="checkbox"/> Home Irrigation, <input type="checkbox"/> Municipal, <input type="checkbox"/> Industrial, <input type="checkbox"/> Fish Pond, etc.			

<b>PUMP DATA</b>			
PUMP TYPE (Circle One): <input checked="" type="radio"/> Submersible, <input type="radio"/> Turbine, <input type="radio"/> Jet <input type="radio"/> Flowing Well, Other (Describe) _____			
POWER TYPE (Circle One): <input checked="" type="radio"/> Electric, <input type="radio"/> Tractor, <input type="radio"/> Diesel, <input type="radio"/> Gasoline, <input type="radio"/> Butane, Other (Describe) _____			
Pump Capacity (GPM) <b>10</b>	No. of Stages <b>15</b>	Setting Depth <b>110</b> FT.	
PUMP TEST			
Well yielded _____ GPM with a drawdown of _____ ft. after _____ hours of pumping			

<b>WELL DATA</b>		
Well Depth <b>120</b>	Casing Diameter (In.) <b>4</b>	Casing Length (Ft.) <b>110</b>
Type of Casing <b>PVC</b>	Hole Depth <b>120</b>	Depth to Static Water Level <b>85</b>
TYPE OF COMPLETION: (Circle One or More): Gravel Packed, <input type="checkbox"/> Underreamed, <input type="checkbox"/> Telescoped, Natural Development, <input type="checkbox"/> Open Hole, <input type="checkbox"/> Other (Describe) <b>100% cement grout</b>		
Top of Lap Pipe or Reduction in Casing		
FEET <input type="checkbox"/> IF TELESCOPED OR MORE THAN ONE SCREEN: USE BACK PAGE		

<b>LOG DATA</b>	
TYPE OF LOG RUN (Circle One): <input type="radio"/> No Log Run, <input type="radio"/> Electric, <input type="radio"/> Gamma Ray, <input type="radio"/> Density, <input type="radio"/> Sonic, <input type="radio"/> Neutron, Other (Describe) _____	
Name of Organization Running Log	

<b>SCREEN DATA</b>		
Diameter - Inches <b>4</b>	Length - Feet <b>10</b>	Slot Size - Inches <b>.012</b>
Screen Type <b>PVC</b>	Depth to Bottom - Feet <b>110</b>	

<b>GEOLOGIC DATA (Office Use Only)</b>			
Surface Elev.	Geologic Unit	Unit Thickness	Depth to Top
Subs. SWL	Date	Analysis	Aquifer Test

Driller's Remarks

DESCRIPTION OF FORMATIONS ENCOUNTERED	FROM	TO	FORMATIONS (Continued)	FROM	TO
Top Soil	0	1			
SANDY clay	1	60			
SHALE	60	85			
SAND	85	120			


**RECEIVED**  
**MAY 05 1994**

Dept. of Environmental Quality  
Office of Land & Water Resources

IF MORE SPACE IS NEEDED, USE BACK

If well telescopes please sketch and show depths.

GROUND LEVEL

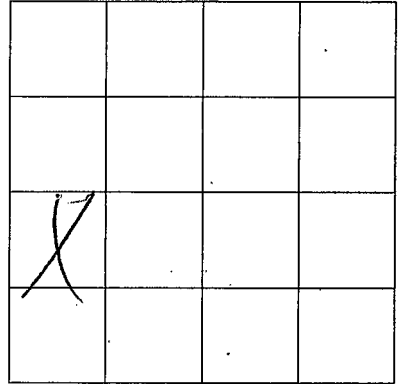

SECTION 4

Please indicate well location X.

ADDITIONAL INFORMATION

If more than one screen,  
show location of each on sketch.