

MISSISSIPPI DEPARTMENT OF ENVIRONMENTAL QUALITY

Office of Land and Water Resources

P. O. Box 10631  
Jackson, MS 39289-0631

WATER WELL DRILLERS LOG

COUNTY WELL LOCATED  
*Madison*

WELL NUMBER *2-2120* CODED

DATE WELL COMPLETED  
*8-18-01*

PERMIT NUMBER  
*079*

NAME OF DRILLING FIRM  
*Reeves Well Ser.*

NAME & MAILING ADDRESS OF LANDOWNER  
*Richard F. Thaller  
Rokoma*

Latitude:  
Longitude:

WELL LOCATION: SEC *23* TOWNSHIP *3* RANGE *N 12 E*

DISTANCE *8* Miles DIRECTION *W* of NEAREST TOWN *Columbia*

OTHER LANDMARK

WELL PURPOSE: Home, Irrigation, Municipal, Industrial, Fish Pond, etc.  
*Home*

PUMP DATA

PUMP TYPE (Circle One):  
Submersible, Turbine, Jet, Flowing Well,  
Other (Describe)

POWER TYPE (Circle One):  
Electric, Tractor, Diesel, Gasoline, Butane,  
Other (Describe) *H/P*

DESCRIPTION OF FORMATIONS ENCOUNTERED	FROM	TO
<i>Clay</i>	<i>0</i>	<i>20</i>
<i>sand</i>	<i>20</i>	<i>60</i>
<i>Chalk</i>	<i>60</i>	<i>100</i>
<i>lobby sand</i>	<i>100</i>	<i>130</i>
<i>sand &amp; clay gravel</i>	<i>130</i>	<i>150</i>

WELL DATA

Well Depth *150'* Casing Diameter (In.) *4"* Casing Length (Ft.) *20'*

Type of Casing *PVC* Hole Depth *150'* Depth to Static Water Level *80'*

TYPE OF COMPLETION: (Circle One or More):  
Gravel Packed, Underreamed, Telescoped,  
Natural Development, Open Hole, Other  
(Describe) *10 Gal. sand*

WELL GROUTED TO A DEPTH OF *10* FEET  
Type Grout (circle one): Cement, Bentonite, or Mix

SCREEN DATA

Diameter - Inches *4"* Length - Feet *10'* Slot Size - Inches *10/32"*

Screen Type *PVC* Depth to Bottom - Feet *15'*

RECEIVED  
FEB 2002  
BY: OLWR

Top of Lap Pipe or Reduction in Casing  
FEET IF TELESCOPED OR MORE THAN ONE SCREEN: USE BACK PAGE

I certify that the well was drilled, constructed and completed in accordance with all applicable Requirements of the Mississippi Department of Environmental Quality and/or the Mississippi Department of Health regulations and state laws.


*Jimmy Reeves 0668*  
Signature of Licensed Driller and License No.

*2-13-02*  
Date

Additional Information Required On Back

If well telescopes please sketch and show depths.

GROUND LEVEL

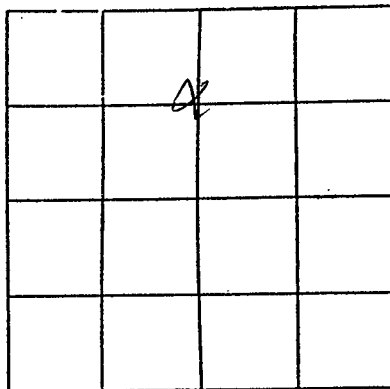

SECTION 23

Please indicate well location X.

Pump Capacity (GPM) <u>10</u>	No. of Stages <u>8</u>	Setting Depth <u>110</u> FT.
----------------------------------	---------------------------	---------------------------------

PUMP TEST

Well yielded 50 GPM with  
a drawdown of 0 ft.  
after 1 hours of pumping

LOG DATA

TYPE OF LOG RUN (Circle One): No Log Run,  
Electric, Gamma Ray, Density, Sonic, Neutron,  
Other (Describe) \_\_\_\_\_

Name of Organization Running Log \_\_\_\_\_

GEOLOGIC DATA (Office Use Only)

Surface Elev.	Geologic Unit	Unit Thickness	Depth to Top
Subs. SWL	Date	Analysis	Aquifer Test

Driller's Remarks

If more than one screen,  
show location of each on sketch.