

MARION  
K  
7-7-78

MISSISSIPPI  
BOARD OF WATER COMMISSIONERS  
416 North State Street  
Jackson, Mississippi 39201

WATER WELL DRILLERS LOG

7/7 date well completed 1978 Hollingsworth Well S. MARION county well located


LANDOWNER: Clifford Sumbert RT 2	description of formations encountered	from	to
Forworth, yms (mailing address)	CLAY CHALK - pebbles	0	15 68
<b>WELL LOCATION:</b>			
sec 36-T-20N R-79E-13E AT miles James town (distance) (direction) (nearest town)			
<b>WELL PURPOSE:</b> Home (home, irrigation, municipal, industrial)			
<b>WELL COMPLETION DATA:</b>			
(1) diameter (inches) 2			
(2) total depth (feet) 68			
(3) static water level (feet) 6 <sup>below</sup> <sub>above</sub> top of ground.			
(4) casing PVC, 63 (material) (depth)			
(size) if telescope see back.			
(5) screen 5, 63 (length) (depth to top)			
2, PVC (size) (material)			
(6) pump 1/2, 10 (HP) (yield gpm)			
elect (type power)			
(7) electric log _____ (yes or no)			
(organization running log)			
(8) how well bottom plugged sand SHARIE			
DRILLERS REMARKS: good well			

RECORDED  
AUG 14 1978

MISS. BD. OF WATER COMMISSIONERS

If well telescopes please sketch and show depths.

GROUND LEVEL

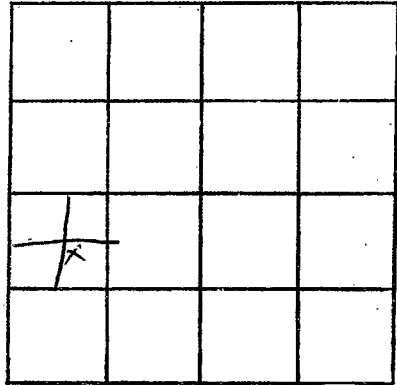

SECTION 36

Please indicate well location X.

ADDITIONAL INFORMATION

If more than one screen,  
show locations of each on sketch.