

MARION
K
5-21-77

MISSISSIPPI
BOARD OF WATER COMMISSIONERS
416 North State Street
Jackson, Mississippi 39201

13V

WATER WELL DRILLERS LOG

5-21 19 77 *Fitzgerald* *Marion*
date well completed firm name county well located

LANDOWNER:	description of formations encountered	from	to
<i>A. Slocum</i>			
<i>R.R. Foxworth</i> (mailing address)	<i>Red clay</i>	<i>12</i>	<i>20</i>
	<i>White sand</i>	<i>20</i>	<i>160</i>
	<i>Coarse sand & gravel</i>	<i>160</i>	<i>175</i>
WELL LOCATION:			
sec. <i>30</i> T. <i>3</i> N. R. <i>19</i> E S			
<i>4</i> miles <i>W</i> of <i>Foxworth</i> (distance) (direction) (nearest town)			
WELL PURPOSE:			
<i>Home</i> (home, irrigation, municipal, industrial)			
WELL COMPLETION DATA:			
(1) diameter (inches) <i>4</i>			
(2) total depth (feet) <i>175</i>			
(3) static water level (feet) <i>130</i> below top of ground.			
(4) casing <i>PVC</i> , <i>167</i> , (material) (depth)			
<i>4</i> (size) If telescope see back.			
(5) screen <i>8</i> , <i>167</i> (length) (depth to top)			
<i>4</i> , <i>PVC</i> (size) (material)			
(6) pump <i>3/4</i> , <i>15</i> (HP) (yield gpm)			
<i>Electric</i> (type power)			
(7) electric log <i>No</i> (yes or no)			
<i>None</i> (organization running log)			
(8) how well bottom plugged <i>Sealed</i>			
DRILLERS REMARKS:			


RECEIVED

JUL 5 - 1977

MISS. BD. OF WATER COMMISSIONERS

If well telescopes please sketch and show depths.

GROUND LEVEL

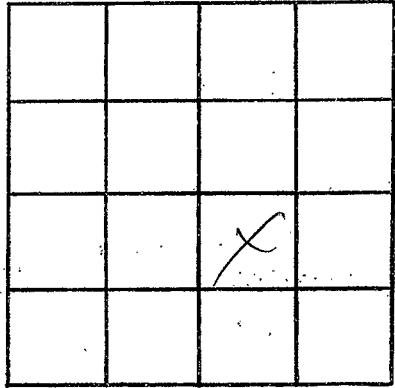

SECTION 30

Please indicate well location X.

ADDITIONAL INFORMATION

If more than one screen,
show locations of each on sketch.