

Marion
~~R~~
11-3-75

MISSISSIPPI
 BOARD OF WATER COMMISSIONERS
 416 North State Street
 130 Jackson, Mississippi 39201

WATER WELL DRILLERS LOG

11-3 1975 Hollinger Plumb. & Water Marion
 date well completed firm name county well located

LANDOWNER: Gene Hollinger
Rt 2 Box 11
Foxworth, Miss. 39483
 (mailing address)

description of formations encountered	from	to
Red clay	0	10
SAND & GRAVEL	10	65
Rock & GRAVEL	65	100
chalk	100	105
sand	105	239
Chalk	239	600

WELL LOCATION:
 Sec. 2 T. S N. S R. W E. W
2 miles S of Foxworth
 (distance) (direction) (nearest town)

WELL PURPOSE: IRRIGATION
 (home, irrigation, municipal, industrial)


- WELL COMPLETION DATA:
- (1) diameter (inches) 2"
 - (2) total depth (feet) 600 ft
 - (3) static water level (feet) 10 below above top of ground.
 - (4) casing 2" S. 40 pl. 235
 (material) (depth)
 (size) If telescope see back.
 - (5) screen 25 210
 (length) (depth to top)
2" sced. 40 pl.
 (size) (material)
 - (6) pump None 10
 (HP) (yield gpm)
None
 (type power)
 - (7) electric log None
 (yes or no)
None
 (organization running log)
 - (8) how well bottom plugged sand
shark

DRILLERS REMARKS: Good well

RECEIVED
 DEC 10 1975
 WATER COMMISSION

If well telescopes please sketch and show depths.

GROUND LEVEL

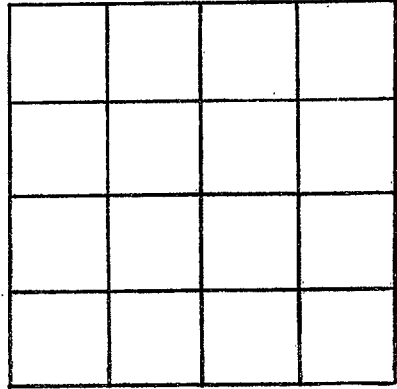

SECTION _____

Please indicate well location X.

ADDITIONAL INFORMATION

2 miles South of
Foxworth

If more than one screen,
show locations of each on sketch.