

Marion
K5
9-66
Elec Log

MISSISSIPPI
BOARD OF WATER COMMISSIONERS
416 North State Street
Jackson, Mississippi 39201

CODED
INDEXED

WATER WELL DRILLERS LOG

Sept 1 1966 Graver Drilling Service, Inc Madison
date well completed firm name county well located


LANDOWNER:	description of formations encountered	from	to
<u>Foxworth</u>	<u>TOP SOIL</u>	<u>0</u>	<u>2</u>
<u>Water Ass'n</u>	<u>CLAY</u>	<u>2</u>	<u>60</u>
<u>Foxworth Miss</u> (mailing address)	<u>SAND & GRAVEL</u>	<u>60</u>	<u>264</u>
	<u>CLAY</u>	<u>264</u>	<u>392</u>
WELL LOCATION:	<u>SAND & GRAVEL</u>	<u>392</u>	<u>564</u>
sec. <u>11 T 3 N</u> R. <u>13 E</u>	<u>CLAY</u>	<u>564</u>	<u>688</u>
<u>S</u> <u>W</u>	<u>SAND</u>	<u>688</u>	<u>712</u>
(distance) miles _____ of _____			
(direction) (nearest town)			
WELL PURPOSE: <u>MUNICIPAL</u> (home, irrigation, municipal, industrial)			
WELL COMPLETION DATA:			
(1) diameter (inches) <u>8 1/2"</u>			
(2) total depth (feet) <u>713'</u>			
(3) static water level (feet) <u>+8</u> below above top of ground.			
(4) casing <u>Steel</u> , <u>687'</u> (material) (depth)			
<u>8 1/2"</u> (size) if telescope see back.			
(5) screen <u>25'</u> , <u>688'</u> (length) (depth to top)			
<u>6"</u> , <u>Stainless Steel</u> (size) (material)			
(6) pump <u>10</u> , <u>100</u> (HP) (yield gpm)			
<u>Electric</u> (type power)			
(7) electric log <u>yes</u> (yes or no)			
<u>USRS # 4-28-66</u> (organization running log)			
(8) how well bottom plugged <u>BACK</u> <u>WASH W/ SAND</u>			
DRILLERS REMARKS:			

CODED
INDEXED

MISSISSIPPI
BOARD OF WATER COMMISSIONERS

If well telescopes please sketch and show depths.

GROUND LEVEL

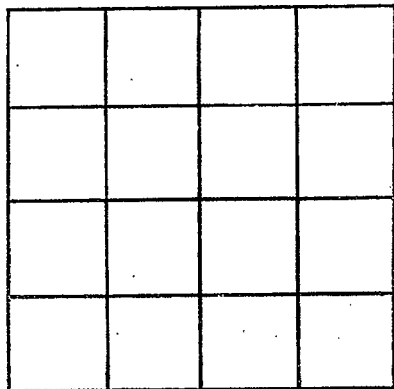

SECTION _____

Please indicate well location X.

ADDITIONAL INFORMATION

If more than one screen, show locations of each on sketch.