

Marion
 R14
 1-3-69

MISSISSIPPI
 BOARD OF WATER COMMISSIONERS
 416 North State Street
 Jackson, Mississippi 39201

CODED
 CODED
 CODED

WATER WELL DRILLERS LOG

Jan 3 1969 date well completed
 Fitzgerald Well Drilling firm name
 Marion county well located

LANDOWNER: W. F. Festerberg

description of formations encountered	from	to
---------------------------------------	------	----

RR. Foxworth, Miss.
 (mailing address)

Red clay	0	20
Red sand & gravel	10	60
Coarse sand & gravel	60	82

WELL LOCATION:
 sec 21 T 3 N R 35 E
 2 1/2 miles W of Foxworth
 (distance) (direction) (nearest town)

WELL PURPOSE: Home
 (home, irrigation, municipal, industrial)

WELL COMPLETION DATA:


- (1) diameter (inches) 4
- (2) total depth (feet) 82
- (3) static water level (feet) 30 below top of ground.
- (4) casing Plastic 76" (material) (depth)
 4 (size) if telescope see back.
- (5) screen 6' 76" (length) (depth to top)
 4" plastic (size) (material)
- (6) pump ? (HP) ? (yield gpm)
 (type power)
- (7) electric log No (yes or no)
 (organization running log)
- (8) how well bottom plugged road log

DRILLERS REMARKS:

FEB 13 1969
 MISSISSIPPI
 STATE BOARD OF WATER COMMISSIONERS

If well telescopes please sketch and show depths.

GROUND LEVEL

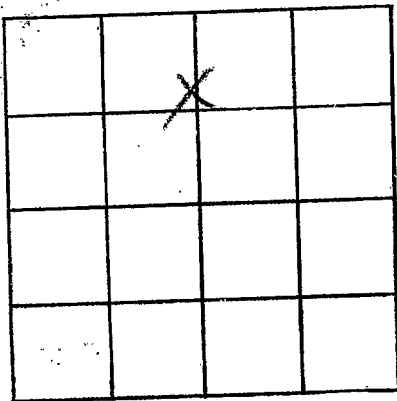

SECTION 21

Please indicate well location X.

ADDITIONAL INFORMATION

If more than one screen,
show locations of each on sketch.