

MARION MISSISSIPPI BOARD OF WATER COMMISSIONERS

RK15
5-21-66

WATER WELL DRILLERS LOG

CODED

Date: 5-21, 1966, Driller: S. S. P... County Marion
(Name)

(1) Owner of Land: H. E. Ball
(Name)
Traxworth
(Address)
(2) Location: 1/4, 1/4, Sec. 14 3-13, T. R
1/2 miles north, of Columbia
(distance) (direction) (Nearest Town)
(3) Topography: Traxworth
(Hilly) (Flat) (Level)
(4) Purpose of Well: Domestic
(Domestic Irrigation
Municipal, Industrial, Other)


Description & Color of Materials Sand, Clay, Red Clay, Shell, etc.	Thick- ness Feet	Depth Feet
<u>white sand</u>	<u>24</u>	
<u>Blue clay</u>	<u>100</u>	
<u>water sand</u>	<u>35</u>	
		<u>160</u>

CODED

Information upon completion of well:

(1) Diameter 2 1/2 inches.
(2) Total Depth 160 feet.
(3) Water Level flowing feet below top of ground.
(4) Cased to 160, Size 2 1/2
(5) Screen: Size 2mm, Length _____
(6) Were any formations sealed against pollution?
_____ yes, ✓ no.

If YES depth of formation _____
Why _____
Drillers Remarks: _____

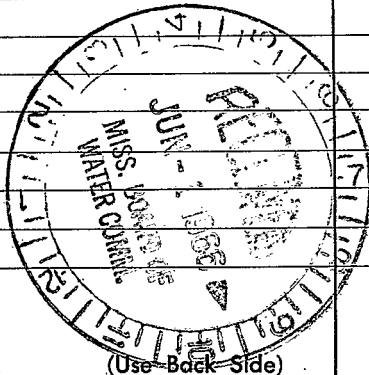

Well No.

