

MARION MISSISSIPPI BOARD OF WATER COMMISSIONERS

K 18
4-10-66

WATER WELL DRILLERS LOG

CODED

Date: 4-10, 1966 Driller: SS ROUSE County: Marion

(Name)

(1) Owner of Land: George Smith
(Name)
Foxworth Inc.
(Address)

(2) Location: 1/4, 1/4, Sec. 29 313 T R
5 miles SW of Columbia
(distance) (direction) (Nearest Town)

(3) Topography: ✓
(Hilly) (Flat) (Level)

(4) Purpose of Well:
(Domestic Irrigation, Municipal, Industrial, Other)

Description & Color of Materials Sand, Clay, Red Clay, Shell, etc.	Thick-ness Feet	Dep-Feet
<u>Red clay</u>	<u>20</u>	<u>20</u>
<u>Red sand</u>	<u>180</u>	<u>200</u>
<u>pea gravel</u>	<u>15</u>	<u>215</u>

Information upon completion of well:

(1) Diameter 4 inches.

(2) Total Depth 215 feet.

(3) Water Level 175 feet below top of ground.

(4) Cased to 205', Size 4"


(5) Screen: Size 4", Length 10'

(6) Were any formations sealed against pollution?
 yes, no.

If YES depth of formation _____

Why _____

Drillers Remarks: _____

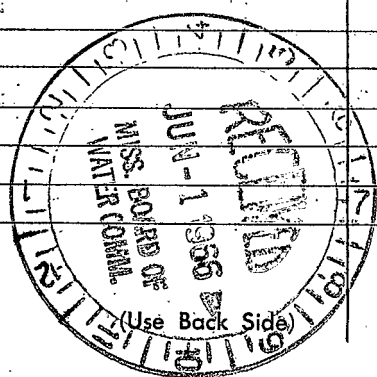

Well No.

for your office files.

