

MARION

WATER WELL DRILLERS LOG

K 19

Date: 5-7-66, 1966, Driller: E. B. SHERKARD County: MARION

(Name)

(1) Owner of Land: SHELBY REGAN (Name)

Foxworth, Miss. (Address)

(2) Location: 1/4, 1/4, Sec. 35 T. 3N. R. 13W. (Nearest Town)

3 1/2 miles S of FOXWORTH (distance) (direction)

(3) Topography: (Hilly) (Flat) (Level) [Level checked]

(4) Purpose of Well: SMALL INDUSTRY (Domestic Irrigation, Municipal, Industrial, Other)

Description & Color of Materials Sand, Clay, Red Clay, Shell, etc.	Thick- ness Feet	Dep Fe
HARD CLAY		
BRAY	20	
SAND & CLAY	"	
MIXED	30	
"	"	
SAND & PFA	"	
GRAVEL	49	

Information upon completion of well:

(1) Diameter 4" inches.

(2) Total Depth 49 feet.

(3) Water Level 19 feet below top of ground.

(4) Cased to 49', Size 4"

(5) Screen: Size 4x10", Length


(6) Were any formations sealed against pollution? yes, [no checked]

If YES depth of formation

Why

Drillers Remarks:

CODED

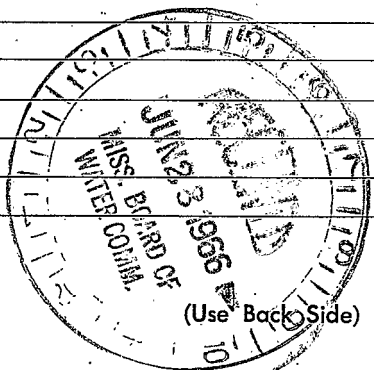

in this copy for your office files.

Well No.

