

Marion
K 20
9-66

MISSISSIPPI BOARD OF WATER COMMISSIONERS

CODED

WATER WELL DRILLERS LOG

Date: 9-17, 1966, Driller: Aic Fitzgerald County Marion
(When well drilled) (Name) (Where well is located)

1) Owner of Land: R. Smith
(Name)
Foxworth
(Address)

2) Location: NE 1/4, NW 1/4, Sec. 29 T. 3 R. 15
5 miles SW of Foxworth
(distance) (direction) (Nearest Town)

3) Topography: X Hilly
(Hilly) (Flat) (Level)

4) Purpose of Well: Domestic
(Domestic Irrigation
Municipal, Industrial, Other)

| Description & Color of Materials Sand, Clay, Red Clay, Shell, etc. | Thick- ness Feet | Depth Feet |
|---|------------------------|---------------|
| <u>0-20 Topsoil</u> | <u>20</u> | <u>20</u> |
| <u>Red sand</u> | <u>40</u> | <u>60</u> |
| <u>Fine sand + gravel</u> | <u>30</u> | <u>90</u> |
| <u>Fine red sand</u> | <u>86</u> | <u>176</u> |
| <u>Heavy gravel</u> | <u>6</u> | <u>182</u> |
| <u>Shale white sand</u> | <u>15</u> | <u>197</u> |
| <u>Coarse sand + gravel</u> | <u>14</u> | <u>211</u> |

Information upon completion of well:

1) Diameter 4 inches.

2) Total Depth 210 feet.

3) Water Level 165 feet below top of ground.

4) Cased to 205, Size 4"

5) Screen: Size 2", Length 5'

6) Were any formations sealed against pollution?
_____ yes, _____ no.

YES depth of formation _____


Why _____

Drillers Remarks: _____

Yield in gpm: 12 gpm

Size pump: 9

Type power: !

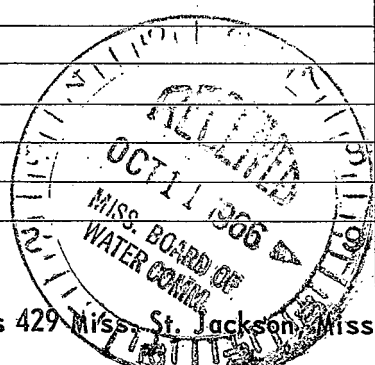

Mail this copy to Board of Water Commissioners 429 Miss. St. Jackson, Miss.

