

MARION
K 21
6-67

MISSISSIPPI
BOARD OF WATER COMMISSIONERS **CODED**
416 North State Street
Jackson, Mississippi 39201

WATER WELL DRILLERS LOG

6-18 1967 Reagan J. Fail Marion
date well completed firm name county well located


LANDOWNER: <u>W. L. Thomsen</u>	description of formations encountered	from	to
<u>Forworth, Miss</u>	<u>Clay</u> <u>Coarse sand</u>	<u>0</u> <u>50</u>	<u>50</u> <u>86</u>
(mailing address)			
WELL LOCATION: <u>1913E</u> sec. <u>31</u> T. <u>30</u> S. R. <u>70</u> E. <u>6</u> miles <u>SE</u> of <u>Kotomo</u> (distance) (direction) (nearest town)			
WELL PURPOSE: <u>home</u> (home, irrigation, municipal, industrial)			
WELL COMPLETION DATA:			
(1) diameter (inches) <u>2 1/2</u>			
(2) total depth (feet) <u>86'</u>			
(3) static water level (feet) <u>15</u> <u>below</u> top of ground.			
(4) casing <u>Galv.</u> <u>83'</u> (material) (depth)			
_____ if telescope see back.			
(5) screen <u>3'</u> <u>83'</u> (length) (depth to top)			
<u>0/0</u> <u>Stainless Steel</u> (size) (material)			
(6) pump <u>1</u> _____ (HP) (yield gpm)			
<u>Elect.</u> (type power)			
(7) electric log <u>no</u> (yes or no)			
_____ (organization running log)			
(8) how well bottom plugged <u>Back</u> <u>wash valve</u>			
DRILLERS REMARKS:			

CODES

EXAM - 5 1967
MISS. BOARD OF
WATER COMMISSIONERS

If well telescopes please sketch and show depths.

GROUND LEVEL

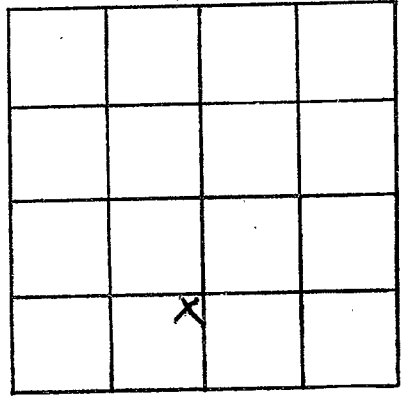

SECTION 31

Please indicate well location X.

ADDITIONAL INFORMATION

If more than one screen, show locations of each on sketch.