

CODED

CODED

MISSISSIPPI  
 BOARD OF WATER COMMISSIONERS  
 416 North State Street  
 Jackson, Mississippi 39201

Marion  
 R 22  
 10-5-68

WATER WELL DRILLERS LOG

10-5-68 19 Dean Griner firm name Marion county well located  
 date well completed

LANDOWNER:  
Travis Holt  
Route 2, Forward  
 (mailing address)

description of formations encountered	from	to
<u>sand &amp; clay</u>	<u>0</u>	<u>80</u>
<u>sand &amp; gravel</u>	<u>80</u>	<u>90</u>
<u>water sand</u>	<u>90</u>	<u>160</u>
	<u>160</u>	<u>207</u>

WELL LOCATION:  
 sec. 24 T. 3 N. R. 9 E.  
2 miles South of Jonestown  
 (distance) (direction) (nearest town)

description of formations encountered	from	to
<u>sand &amp; clay</u>	<u>0</u>	<u>80</u>
<u>sand &amp; gravel</u>	<u>80</u>	<u>90</u>
<u>water sand</u>	<u>90</u>	<u>160</u>
	<u>160</u>	<u>207</u>

WELL PURPOSE:  
home  
 (home, irrigation, municipal, industrial)

WELL COMPLETION DATA:

(1) diameter (inches) 3"

(2) total depth (feet) 207'

(3) static water level (feet) 167' below top of ground.

(4) casing Galv. Pipe  
 (material) (depth)

(size) if telescope see back.

(5) screen 4"  
 (length) (depth to top)

(size) (material)


(6) pump \_\_\_\_\_  
 (HP) (yield gpm)

(type power)

(7) electric log \_\_\_\_\_  
 (yes or no)

(organization running log)

(how well bottom plugged)

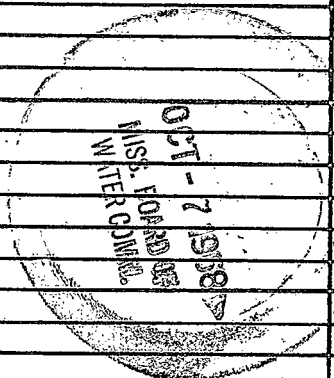

REMARKS:

If well telescopes please sketch and show depths.

GROUND LEVEL


SECTION \_\_\_\_\_

Please indicate well location X.

ADDITIONAL INFORMATION

If more than one screen, show locations of each on sketch.