

Marion  
 R24  
 10-8-69

MISSISSIPPI  
 BOARD OF WATER COMMISSIONERS  
 416 North State Street  
 Jackson, Mississippi 39201

CODED

WATER WELL DRILLERS LOG

10-8-69 date well completed 1969 firm name Fitzgould well Co. Marion county well located

LANDOWNER:  
 Roy Smith  
 RR. Foxworth, Miss.  
 (mailing address)

WELL LOCATION:  
 sec. 29 T. 3 N. R. 19 W.  
 S  
 5 miles SE of Foxworth  
 (distance) (direction) (nearest town)

WELL PURPOSE: Home  
 (home, irrigation, municipal, industrial)

WELL COMPLETION DATA:

(1) diameter (inches) 4

(2) total depth (feet) 225

(3) static water level (feet) 155 below top of ground.

(4) casing plastic, 217, (material) (depth)  
 4 (size) if telescope see back.

(5) screen 8, 217 (length) (depth to top)  
 4, plastic (size) (material)

(6) pump 3/4, 10 (HP) (yield gpm)  
 elec (type power)

(7) electric log no (yes or no)  
 (organization running log)

(8) how well bottom plugged wood py

description of formations encountered	from	to
Red clay	0	15
Red sand	15	90
white clay	90	180
fine sand	180	210
Coarse sand & gravel	210	225


DRILLERS REMARKS:

OCT 20 1969

WELL DRILLERS ASSOCIATION

If well telescopes please sketch and show depths.

GROUND LEVEL

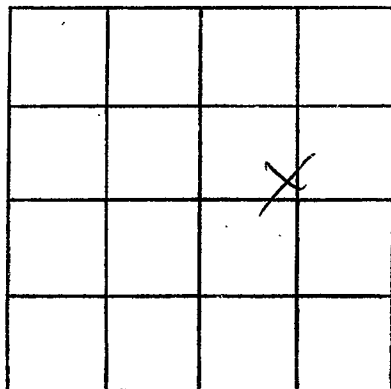

SECTION 29

Please indicate well location X.

ADDITIONAL INFORMATION

If more than one screen,  
show locations of each on sketch.