

MARION
K 27
11- 69

MISSISSIPPI
BOARD OF WATER COMMISSIONERS
416 North State Street
Jackson, Mississippi 39201

CODED

WATER WELL DRILLERS LOG

Nov. 1969 E. B. Sheppard Marion
date well completed firm name county well located

LANDOWNER:	description of formations encountered	from	to
Marshall Inelip Joxworth, Miss. (mailing address)	SANDY RED CLAY GRAVEL SAND	0 90	90 163
WELL LOCATION:			
sec 21 T 30 ^N R 19 ^E 5 miles SW of Columbia (distance) (direction) (nearest town)			
WELL PURPOSE: (home, irrigation, municipal, industrial)			
WELL COMPLETION DATA:			
(1) diameter (inches) 2"			
(2) total depth (feet) 163'			
(3) static water level (feet) 110 below top of ground.			
(4) casing Plastic 163 (material) (depth)			
2" if telescope see back. (size)			
(5) screen 3' (length) (depth to top)			
2 1/2 S.S. (size) (material)			
(6) pump 1 1/2 8 (HP) (yield gpm)			
(type power)			
(7) electric log (yes or no)			
(organization running log)			
(8) how well bottom plugged BOW			
DRILLERS REMARKS:			


CODED

FER 5 - 1970

WELL DRILLER
LICENSE NO. 11111
ISSUED 1/1/68

If well telescopes please sketch and show depths.

GROUND LEVEL

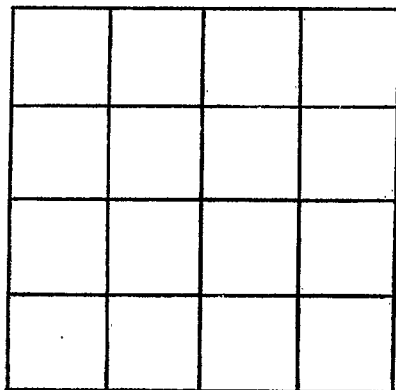

SECTION _____

Please indicate well location X.

ADDITIONAL INFORMATION

If more than one screen, show locations of each on sketch.