

Marion  
K 28  
12-6-69

MISSISSIPPI  
BOARD OF WATER COMMISSIONERS  
416 North State Street  
Jackson, Mississippi 39201

CODED

WATER WELL DRILLERS LOG

12/6 1969 Dean Gricev Marion  
date well completed firm name county well located

LANDOWNER:

Clifton Holmes  
Route 2, Popworthville  
(mailing address)

description of formations encountered

from to

WELL LOCATION:

sec 30 T3 N R13 E  
S W  
5 miles S.W. of Popworthville  
(distance) (direction) (nearest town)

WELL PURPOSE: Home Use  
(home, irrigation, municipal, industrial)

WELL COMPLETION DATA:

- (1) diameter (inches) 4"
- (2) total depth (feet) 255'
- (3) static water level (feet) 190' below top of ground.
- (4) casing Plastic, 245'  
(material) (depth)
- (size) if telescope see back.
- (5) screen 10' 245'  
(length) (depth to top)
- 4" Plastic  
(size) (material)
- (6) pump 3/4 H.P.  
(HP) (yield gpm)
- McDonald Sub pump  
(type power)
- (7) electric log No.  
(yes or no)
- (organization running log)
- (8) how well bottom plugged

Top soil	0-1
Red clay	1-30
Red sand	30-60
Chalk	60-85
Gravel	85-115
Chalk	115-165
red sand	165-180
fine sand	180-220
Coarse water sand	220-255

CODED


MAR 18 1970

MISS. BD. OF  
WATER COMMISSIONERS

DRILLERS REMARKS:

If well telescopes please sketch and show depths.

GROUND LEVEL

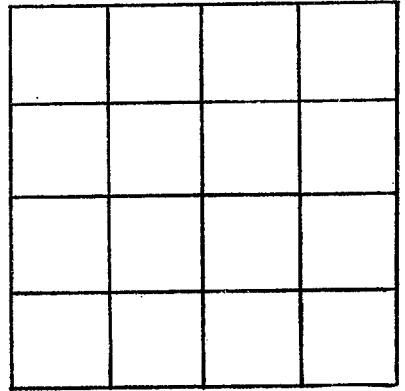

SECTION \_\_\_\_\_

Please indicate well location X.

ADDITIONAL INFORMATION

If more than one screen, show locations of each on sketch.